

FILED

MAY 16 1997

DEC 18 10 23 AM '96

LAND CORNER RECORDATION CERTIFICATE
Filing Requirement of Act 74, Mich. P.A. 1970

For corners in Pine Grove Township
Van Buren County
 (County)

Located In:

Corner Code #

 1. Public Land Survey
 W 1/4 Post, Sec. 10
T 1S R 13WG-4 pm
 2. Property Controlling
 in Section
S T R
 3. Miscellaneous
 Property in Sec.
S T R 4. Lot No. , Recorded Plat 5. Private Claims

I, Donald R. Gilchrist, in a field survey on December 10, 1996 do hereby state that under requirements of P.A. 74, Michigan P.A. of 1970, the corner points mentioned in lines 1 and 2 above were in conformance with regulations and rules therefore as required in the current manual of survey instructions of the United States Department of the Interior, Bureau of Land Management or by a decree of a Court of Law and/or that the corner points mentioned in lines 3, 4 and 5 above were in conformance with the rules of the Michigan Board of Land Surveyors or by a Decree of a Court of Law; established, re-established, monumented, recovered, found as expressed below:

NOTE: Not more than 2 corners, all in the same town and range, may be recorded on this certificate.

A. Description of original monument and accessories and/or subsequent restoration:

1830 - GOVERNMENT - R. Clark, Jr., D.S.

Ran North between Section 9 and 10 a distance of 40 chs (2640.00') and set Quarter Section Post.

Witnesses:

9" White Oak - S 39° E - 79 lks (52.14').

18" White Oak - S 21° W - 100 lks (66.00').

(Continued on back of Certificate)

B. Description of corner evidence found and/or method applied in restoring or reestablishing corner:

Found Harrison marker in Monument Box marked "V.B. Co. Road Comm".

Approved at the 12/4/96 meeting of the Van Buren County Peer Group and is accepted as the best available evidence of the position of the original corner.

Ratified by Peer Group in
 accordance with P.A. 345 of 1990
 Van Buren County Surveyor

Date 12/18/96 D. R. A.

C. Description of monument for corner and accessories established to perpetuate locating the position of the corner:

Harrison Marker in Monument Box.

24" White Oak - S 5° W - 30.51' - Pk & Washer - W side.

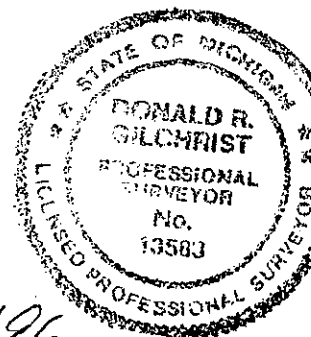
18" Maple - S 50° W - 68.13' - Pk & Washer - N side.

16" Hickory - N 5° W - 15.13' - Pk & Washer - W side.

16" White Oak - N 70° W - 72.95' Pk & Washer - S side.

3' N of CL Road.

ROW of Map. - South.

Signed by Donald R. GilchristDate 12/18/96Surveyor's Michigan License No. RLS 13583

8/13/1973 - D. R. Gilchrist, C.S. (Smith and Smith).

Section 10.

Recorded Survey (Liber 4 - Page 4).

Shows breakdown of Southwest Quarter.

Distance South is 2648.98'.

Distance East is 2647.34'.

Set iron in monument box in line with fence and tree row South and 4' North of centerline of road.

Witnesses:

14" Oak - S 10° W - 30.54' to nail.

12" Maple - S 65° W - 67.78' to nail.

14" Oak - N 65° W - 81.86' to nail.

8/14/1973 - Recorded Survey (Liber 4 - Page 188).

Same as above.

12/5/1973 - D. A. Middleton, R.L.S. (Smith & Smith).

Recordation Certificate (Liber 2 - Page 241).

Set corner from fence line to South and 33' North of North line of cemetery (Found 2" square markers).

Witnesses same as above.

11/4/1996 - D. R. Gilchrist, C.S.

Found Harrison Marker in Monument Box.