

MEMORANDUM

FILED

MAY 16 1997

COMMISSION

LAND CORNER RECORDATION CERTIFICATE

Filing Requirement of Act 74, Mich. P.A. 1970

DEC 10 8 24 AM '96

For corners in Bloomingdale Township

Mark A. Smith  
VAN BUREN CO.  
REGISTERED PROFESSIONAL SURVEYOR

9.00

Van Buren (County)	Located in:	Corner Code #
1. Public Land Survey	T <u>1S</u> R <u>14W</u>	K-11
SW Corner Section 25	T _____ R _____	_____
	T _____ R _____	_____
	T _____ R _____	_____
2. Property Controlling in Section	S _____ T _____ R _____	_____
	S _____ T _____ R _____	_____
3. Miscellaneous Property in Sec.	S _____ T _____ R _____	_____
	S _____ T _____ R _____	_____
4. Lot No. _____, Recorded Plat _____		
5. Private Claims _____		

Register of Deeds Stamp & File Number

12/09 0101 10SURVEY

I, Donald R. Gilchrist, in a field survey on 10-24, 19 96, do hereby certify that under requirements of P.A. 74, Michigan P.A. of 1970, the corner points mentioned in lines 1 and 2 above were in conformance with regulations and rules therefore as required in the current manual of survey instructions of the United States Department of the Interior, Bureau of Land Management or by a decree of a Court of Law and/or that the corner points mentioned in lines 3, 4 and 5 above were in conformance with the rules of the Michigan Board of Land Surveyors or by a Decree of a Court of Law; established, re-established, monumented, re-monumented, recovered, found as expressed below:

NOTE: Not more than 4 corners, all in the same town and range, may be recorded on this certificate.

A. Description of original monument and accessories and/or subsequent restoration:

1/1830 - GOVERNMENT - R. Clark, Jr. D.S.

North between Sections 35 and 36 a distance of 80.00 chs. (5280.00') and set Post Corner.

Witnesses:

14" Beech - N. 76° E. - 32 lks. (21.12')

16" Beech - W. 24 lks. (15.84')

Distance East is 79.54 chs. (5249.64')

Distance West is 78.66 chs. (5191.56')

B. Description of corner evidence found and/or method applied in restoring or reestablishing corner:

Found Harrison marker in mon. box  
Approved at 9/4/96 meeting of the V.B. Co. Peer Group

Ratified by Peer Group in  
accordance with P.A. 345 of 1990  
Van Buren County Surveyor

Date 12/9/96 D. R. G.

C. Description of monument for corner and accessories established to perpetuate locating the position of the corner:


Same as above

30" Pine - N25° E - 32.03' nail in W. side

16" Map - N55° W - 42.68' nail in S.W. side

P.P. - S15° E - 71.20' to nail in W. side

Tel Ped - S40W - 51.84' to centerline

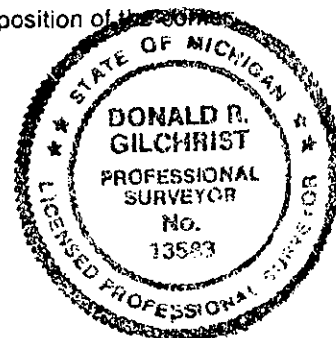

Signed by Donald R. Gilchrist Date 12/6/96  
Surveyor's Michigan License No. RLS 13583

6/20/1852 - G. B. Sherwood, Surveyor

Section 25

Book 1 - Page 19

Distance East is 19.75 chs. (1303.50') to Eighth Post, and continuing East 19.79 chs. (1306.14') to Quarter Post for a total of 2609.64'

Distance North is 2692.8'

3/16/1874 - A. J. Teed, C.S.

Section 25 and 26

Book 4 - Page 151

Stone present

Distance West is 39.27 chs. (2591.82')

7/28/1966 - Consumers Power Co. (W. Q. Smith, C.S. - D. R. Gilchrist, R.L.S.)

"Dug out intersection found cut stone on end and small stones around, set iron net to point on stone"

Distance North is 2638.50'

Distance South is 2634.84'

Distance West is 2594.35'

Angle West to North  $88^{\circ} 45' 17''$

LIBER 4 PAGE 396