

JAN 14 1998

FILED

SECTION

VAN BUREN COUNTY REMONUMENTATION  
LAND CORNER RECORDATION CERTIFICATE  
Filing Requirement of Act 74, Mich. P.A. 1970

Dec 16 12 00 PM '97

For corners in VAN BUREN COUNTY Located in: GENEVA TWP. Corner ID # SE COR. SEC 12 T1S,R16W

Mark A. Smith  
VAN BUREN COUNTY  
SURVEYOR

1. Public Land Survey T 1S R 16W M-5  
T R  
T R  
T R  
2. Property Controlling S T R  
in Section S T R  
3. Miscellaneous S T R  
Property in Sec. S T R  
4. Lot No. Recorded Plat  
5. Private Claims

Liber 5 Page 47

Register of Deeds Stamp & File Number

I, Alan Bartlett in a field survey on December 2 1997 hereby certify that under requirements of P.A. 74, Michigan P.A. of 1970, the corner points mentioned in lines 1 and 2 above were in conformance with regulations and rules therefore as required in the current manual of survey instructions of the United States Department of the Interior, Bureau of Land Management or by a decree of a Court of Law and/or that the corner points mentioned in lines 3, 4 and 5 above were in conformance with the rules of the Michigan Board of Land Surveyors or by a Decree of a Court of Law; established, re-established, monumented, re-monumented, recovered, found as expressed below:

NOTE: Not more than 4 corners, all in the same town and range, may be recorded on this certificate.

	A	B	C	D	E	F	G	H	I	J	K	L	M
2	6	5	4	3	2	1							
3													
4	7	8	9	10	11	12							
5													
6	18	17	16	15	14	13							
7													
8	19	20	21	22	23	24							
9													
10	30	29	28	27	26	25							
11													
12	31	32	33	34	35	36							
13													

Ratified by Peer Group in  
accordance with P.A. 345 of 1990  
Van Buren County Surveyor

Date D. R. A. 12/16/97

A. Description of original monument and accessories and/or subsequent restoration:

5/15/1827 WM. BROOKFIELD  
80.00 SET POST CORNER TO SECTION 12 AND 13  
WITNESSES  
ELM 14" N64½°W 21 LINKS  
BLK ASH 9" S32°W 14 LINKS

4/15/1952 ROSALLA NOTES  
SET PIPE 24.42' NORTH (FOUND STONE)  
SHOWS 2638.34' SOUTH OF EAST 1/4 POST

B. Description of corner evidence found and/or method applied in restoring or reestablishing corner:


FOUND APPROXIMATE FENCE CORNER POST WITNESS TO NORTHEAST (DOWN AND ROTTED) AND USED PREVIOUS SURVEY DISTANCE OF 2638.68' FROM EAST 1/4 CORNER OF SECTION 13 (M-6) TO REESTABLISH POSITION. MATCHES OCCUPATION TO THE WEST. THIS GOVERNMENT MONUMENT WAS RESTORED WITH THE APPROVAL OF THE VAN BUREN COUNTY REMONUMENTATION PEER GROUP OF SURVEYORS ON NOVEMBER 19 1997.

C. Description of monument for corner and accessories established to perpetuate locating the position of the corner:

SET 2½" HARRISON MONUMENT AND MONUMENT BOX 8.05' EAST OF CENTER LINE OF COUNTY ROAD 681 AND 16' NORTH OF CENTER LINE OF TRAIL EAST.

WITNESSES  
N85°E 18.35' EAST END OF CORRUGATED METAL PIPE CULVERT  
S60°E 84.99' SET NAIL AND FLASHER IN SOUTH FACE OF 16" OAK  
SOUTH 24.42' SOUTHWEST CORNER OF SECTION 7 T1S,R15W  
S85°W 44.42' SET NAIL AND FLASHER IN POWER POLE

Corner is accepted as a careful and faithful reestablishment of the position of the original corner.

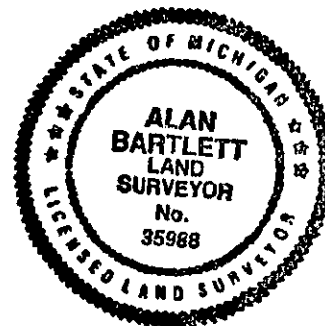

Signed by Alan K. Bartlett  
Michigan License No. 35988

Date 12/15/97

Surveyor's