

SURVEY &  
REMONUMENTATION

JAN 14 1998

LAND CORNER RECORDATION CERTIFICATE  
Filing Requirement of Act 74, Mich. P.A. 1970

FILED

DEC 15 3 56 PM '97

For corners in SECTION

Van Buren Located In: Corner Code #  
(County) Antwerp Township S.W. COR. SEC. 11

1. Public Land Survey T 3 S R 13 W L-5  
T R  
T R  
T R

2. Property Controlling S T R  
in Section S T R

3. Miscellaneous S T R  
Property in Sec. S T R

4. Lot No. , Recorded Plat  
5. Private Claims

I, James E. Boynton, in a field survey on August 18, 1997  
do hereby certify that under requirements of P.A. 74, Michigan P.A. of 1970, the corner points  
mentioned in lines 1 and 2 above were in conformance with regulations and rules therefore as  
required in the current manual of survey instructions of the United States Department of the Interior,  
Bureau of Land Management or by a decree of a Court of Law and /or that the corner points  
mentioned in lines 3, 4 and 5 above were in conformance with the rules of the Michigan Board of  
Land Surveyors or by a Decree of a Court of Law; established, re-established, monumented,  
re-monumented, recovered, found as expressed below:

NOTE: Not more than 4 corners, all in the same town and range, may be recorded  
on this certificate.

	A	B	C	D	E	F	G	H	I	J	K	L	M
1													
2		6		5		4		3		2		1	
3													
4		7		8		9		10		11		12	
5													
6		18		17		16		15		14		13	
7													
8		19		20		21		22		23		24	
9													
10		30		29		28		27		26		25	
11													
12		31		32		33		34		35		36	
13													

A. Description of original monument and accessories and/or subsequent restoration:

Original corner position established in 1830 by William Brookfield, D.S. The corner was used in 1923 by T. A. Smith, C.S. and in 1950 by W. Q. Smith, C.S. but no description of the corner was given. In 1970 D. R. Gilchrist, L.S. found and used a pipe. In 1971 D. A. Middleton, L.S. found and used a 1 1/2" pipe. The corner was used by J. Hunt, L.S. in 1981 but no description of the corner was given.

B. Description of corner evidence found and/or method applied in restoring or reestablishing corner:

Found a 1" pipe from witnesses and accepted as the best available evidence of the corner location.

C. Description of monument for corner and accessories established to perpetuate locating the position of the corner:

Set Standard Remon Monument in place of the pipe as directed by the Peer Group during the regular meeting of July 30, 1997.


Mon. is 4' West of the East edge of a gravel road  
UP N.64 1/2°W. 34.32' to nail  
8" Ash N.76°E. 18.27' to nail  
10" tree S.56°E. 23.84' to nail

Signed by

James E. Boynton  
Surveyor's Michigan License No. 29239

Date

12-12-97

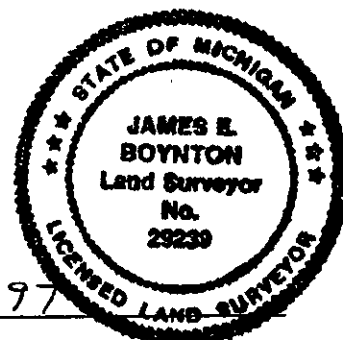

FORM APPROVED BY MICHIGAN STATE BOARD OF LAND SURVEYORS, JAN. 28, 1971  
REVISED MAY 14, 1976  
REVISED JAN., 1983

Ratified by Peer Group in  
accordance with P.A. 345 of 1990  
Van Buren County Surveyor

Date

D. R. G. 12/15/97

L. Bee 5 pg. 38