

SURVEY & REMONUMENTATION

APR 25 1995

COMMISSION

E 1/4 SEC. 12

LAND CORNER RECORDATION CERTIFICATE

Filing Requirement of Act 74, Mich. P.A. 1970

FILED

DEC 22 9 03 AM '94

For corners in ANTWERP TWP.

VAN BUREN
(County)

Located In:

Corner Code ##

- | | | |
|------------------------------------|--------------|-----|
| 1. Public Land Survey | T 3 S R 13 W | M-4 |
| | T R | |
| | T R | |
| | T R | |
| 2. Property Controlling in Section | S T R | |
| | S T R | |
| 3. Miscellaneous Property in Sec. | S T R | |
| | S T R | |

Register of Deeds Stamp & File Number

4. Lot No. _____, Recorded Plat _____
5. Private Claims _____

I, Allen H. McMachen a field survey on December 17, 19 94, do hereby certify that under requirements of P.A. 74, Michigan P.A. of 1970, the corner points mentioned in lines 1 and 2 above were in conformance with regulations and rules therefore as required in the current manual of survey instructions of the United States Department of the Interior, Bureau of Land Management or by a decree of a Court of Law and/or that the corner points mentioned in lines 3, 4 and 5 above were in conformance with the rules of the Michigan Board of Land Surveyors or by a Decree of a Court of Law; established, re-established, monumented, re-monumented, recovered, found as expressed below:

NOTE: Not more than 4 corners, all in the same town and range, may be recorded on this certificate.

	A	B	C	D	E	F	G	H	I	J	K	L	M
2	6	5	4	3	2	1							
3													
4	7	8	9	10	11	12							
5													
6	18	17	16	15	14	13							
7													
8	19	20	21	22	23	24							
9													
10	30	29	28	27	26	25							
11													
12	31	32	33	34	35	36							
13													

A. Description of original monument and accessories and/or subsequent restoration:

1827 - William Brookfield, D.S.

Set Post

1884 - A.A. Fosdick, C.S.

"Relocated quarter post from one old witness stump"

Kalamazoo corner is 2.55 CH. (168.30) North.

1956 - W.Q. Smith, C.S.

1971 - D.R. Gilchrist, R.L.S.

Stone with cross on top

Accessories: 18" Poplar N. 10° W. 56'

Found ± 8" Dia. Stone, dug under Stc found nothing, set "T" Iron from wit.

10" Sassafras 18" Poplar N. 73° W. 27.98'

Accessories: 12" Poplar S. 76° W. 28.0'

S. 63° E. 12' 14" Poplar N. 18° W. 56.10'


16" Poplar N. 73° W. 27.98'

B. Description of corner evidence found and/or method applied in restoring or reestablishing corner: 14" Poplar N. 18° W. 56.1
12" Sassafras N. 63° E. 12'

Found "T" Iron at surface, found 2 of 4 previous witness trees dead and decaying, dug 3' deep and found no additional corner evidence
Found "T" Iron was approved and authorized by the Van Buren County Remonumentation Peer Group.

Ratified by Peer Group in
accordance with P.A. 345 of 1990
Van Buren County Surveyor

Date 12/21/94 DRG

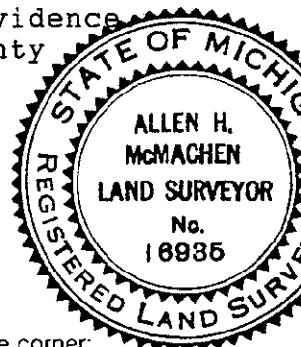

C. Description of monument for corner and accessories established to perpetuate locating the position of the corner:

Found "T" Iron is accepted as a careful and faithful reestablishment of the original corner. Removed "T" Iron and placed Standard Van Buren County Section Corner Monument.
Accessories:

Nail & Tab in 10" Sassafras WEST 8.07'

Nail & Tab in 12" Sassafras N. 20° W. 18.78'

Nail & Tab in 12" Sassafras S. 20° W. 13.78'

center line of Northerly Bolt of 3 Bolts on West side Co. Po. Co.
high voltage tower S. 75° E. 109.38'

Signed by

Allen H. McMachen

Date

12/21/94

Surveyor's Michigan License No.

16935