

FILED

LAND CORNER RECORDATION CERTIFICATE

FILING REQUIREMENT OF ACT 74, MICH. P.A. 1970

Dec 16 9 20 AM '99

N 1/4 Post Sec 22 Paw Paw Twp.

FOR CORNERS OF:

LOCATED IN:

CORNER CODE NUMBER

1. PUBLIC LAND SURVEY T. 3 S. R. 14 W. X

H - 7

2. PROPERTY CONTROLLING IN SECTION T. N. S. R. E. W.

3. MISCELLANEOUS PROPERTY IN SECTION T. N. S. R. E. W.

4. LOT NO. RECORDED PLA

5. PRIVATE CLAIMS

Mark A. Smith
VAN BUREN CO.
REGISTER OF DEEDS

SURVEY &

DEC 28 1999

SECTION

REGISTER OF DEEDS STAMP
AND FILING NUMBER

I, Charles D. Lossie, in a field survey on 08-Dec, 1999 do hereby state that under requirements of P.A. 74, Michigan P.A. of 1970, the corner points mentioned in lines 1 and 2 above were in conformance with regulations and rules therefore as required in the current manual of survey instructions of the United States Department of the Interior, Bureau of Land Management or by a decree of a Court of Law and/or that the corner points mentioned in lines 3, 4 and 5 above were in conformance with the rules of the Michigan Board of Land Surveyors or by a Decree of a Court of Law; established, re-established, monumented, recovered, found as expressed below:

NOTE: Not More than 2 corners, all in the same town and range may be recorded on this certificate.

	A	B	C	D	E	F	G	H	I	J	K	L	M
1													
2	6	5	4	3	2	1							
3													
4	7	8	9	10	11	12							
5													
6	18	17	16	15	14	13							
7													
8	19	20	21	22	23	24							
9													
10	30	29	28	27	26	25							
11													
12	31	32	33	34	35	36							
13													

A. Description of original monument and accessories and/or subsequent restoration:

1830- GOVERNMENT - BROOKFIELD, D.S.

Corrected West between Sections 15 and 22 a distance of 39.575 chs. (2611.95').

Witnesses:

12" Aspen - S. 79° W., 104 lks. (68.64').

No Other Trees

See Back page for additional history.

B. Description of corner evidence found and/or method applied in restoring or re-establishing corner:

Found Base of iron pump and pipe with stones on West side. The position of this Government Monument was accepted and restored with the approval of the Van Buren County Remonumentation Peer Group of Surveyor's meeting on September 1, 1999 as the best available evidence of the position of the original corner.

Ratified by Peer Group in
accordance with P.A. 345 of 1990
Van Buren County Surveyor

Date 12-16-99 D.R.A.

C. Description of monument for corner and accessories established to perpetuate locating the position of the corner:

Tied off pump base and Pipe. Set Harrison Marker.

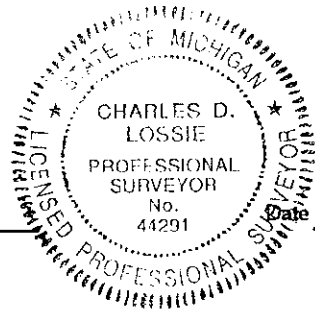
8" Oak, North 6.98' to PK and Washer.

14" Cherry, S. 30° W., 28.81' to PK and Washer.

10" Maple, S. 30° E., 7.92' to PK and Washer.

10" Cherry, East 38.66' to PK and Washer.

1.5' ± West of North and South Fence.

Signed by Charles D. Lossie
CHARLES D. LOSSIE, P.S.Surveyor's Michigan License No. 44291Date 12/14/99

FORM APPROVED BY MICHIGAN STATE BOARD OF PROFESSIONAL SURVEYORS,

JAN. 28, 1971

REVISED

MAY. 5, 1975

REVISED

JAN., 1983

REVISED

OCT., 1996

8751 12/16 0104 10SURVEY

9.00

L. Lossie 5 Pg 288

Liber 5 pg 289

North Quarter Post, Sec 22, Town 3 South, Range 14 West
Paw Paw Twp., (H-7)

Date? Who?

Red Book
Base of iron pump.

Witnesses:

11" Cherry - S. 83°W., 165.5 lks. (109.23').
Distance West is 39.735 chs. (2622.57').
Distance East is 39.735 chs. (2622.57').

SURVEY &
RECORDS

DEC 28 1999

SECTION

5/23/1939 - T.A. SMITH, C.S.

Drawing shows corner.
Distance East is 1637.8' to parcel line.

12/1971 - W.Q. SMITH, C.S.

Sections 15 and 22 (Treatment Plant).
Found iron pipe base.
Distance West is 1312.31' and continuing West 1312.31' to Section Center for a total of 2624.62'.
Distance East is 1310.88' and continuing East 1310.88' to Section Corner for a total of 2621.76'.
Distance North is 1326.26' and continuing North 1326.26' to Center Quarter Post for a total of 2652.52'.
Distance South is 2650.48'.
Recordation Certification (Liber 1 - Page 440) D.A. Middleton, D.S./S & S.

Witnesses:

5" Cherry - West - 30.8' to tack on South side.
8" Elm. - N. 05° E., 6.37' to tack on West side.
8" Poplar - S. 60° E., 5.37' to tack on South side.
Recorded Survey (Liber 1 - Page 317).
Same as above.

9/25/1974 - F. E. SPICER, R.L.S./W. & W.

Section 22
Distance Est is 2621.18'.
Distance South is 2650.28'.

12/23/1991 - D.R. GILCHRIST, C.S.

Section 15
Distance North is 2652.52'.