

1993

VAN BUREN COUNTY REMONUMENTATION PROGRAM

LAND CORNER RECORDATION CERTIFICATE

Filing Requirement of Act 74, Mich. P.A. 1970

OCT 19 11 52 AM '93

LIBER 4 PAGE 66

For corners in

Van Buren
(County)

Located In:
Hartford Twp.

Corner Code #

Mark A. Smith
VAN BUREN CO.
REGISTER OF DEEDS

1. Public Land Survey Sec. 16 T 3 S. R 16 W. G-7
T R
T R
T R
2. Property Controlling S T R
in Section S T R
3. Miscellaneous S T R
Property in Sec. S T R
4. Lot No. , Recorded Plat
5. Private Claims

Register of Deeds Stamp & File Number

	A	B	C	D	E	F	G	H	I	J	K	L	M
2	6	5	4	3	2	1							
3													
4	7	8	9	10	11	12							
5													
6	18	17	16	15	14	13							
7													
8	19	20	21	22	23	24							
9													
10	30	29	28	27	26	25							
11													
12	31	32	33	34	35	36							
13													

I, John C. Hunt, P.S., in a field survey on August 16, 19 93, do hereby certify that under requirements of P.A. 74, Michigan P.A. of 1970, the corner points mentioned in lines 1 and 2 above were in conformance with regulations and rules therefore as required in the current manual of survey instructions of the United States Department of the Interior, Bureau of Land Management or by a decree of a Court of Law and/or that the corner points mentioned in lines 3, 4 and 5 above were in conformance with the rules of the Michigan Board of Land Surveyors or by a Decree of a Court of Law; established, re-established, monumented, re-monumented, recovered, found as expressed below:

NOTE: Not more than 4 corners, all in the same town and range, may be recorded on this certificate.

A. Description of original monument and accessories and/or subsequent restoration:

5/11/1830 Gov. Survey: Wm. Brookfield DS: Cert. notes: N. bet. 21 & 22 80.00 ch & set post cor.: 12" Elm S.17*W. 8 lks., 10" swamp Oak N.27°30'W. 32 lks. 4/22/87 AA Fosdick CS: Worked in E. Sec. 15. 1920+- WH Goss CS: Stone & iron, 20" Elm SW .75 ch 49.5', SW cor. of MH, NE 1.95 ? 4/13/43 TA Smith CS: fd. pc. of iron buried 1' below surface of gravel st.; E. edge conc. walk W.; C/L 24" Elm SW 50.9', C/L 15" Elm N.10°+-E. 139.8' 1950+- WQ Smith CS: Fd. iron bar; 20" Silver Maple N.28°15'E. 59.6' to spike in S. side 1' above ground, 8" Maple N.24°W. 61' to spike in E. side 1' above grd., Cross in top of big rock N.88°30'W. 56.2' 3/20/63 Used cor. 5/19/64 D. Ratekin PS, used cor. 9/27/71 I.W.M. Show cor. as State Cap in mon box. 7/11/72 A. Howard PS, fd. mon box & witnessed. 1/23/73 WQ Smith CS: Rec. wit. L.2 p.53 for fd. MDSH bronze cap in mon box in C/L N&S rd. 5/20/75 I.W.M. fd. mon box, 12" Apple N.35°W. 61.00', U.P. N.35°E. 63.47'.

B. Description of corner evidence found and/or method applied in restoring or reestablishing corner:


G-7 Section corner common to Sections 15, 16, 21, & 22, Hartford Township.
Corner evidence found: On Aug. 16, 1993, Found M.D.S.H. Bronze Cap in Monument Box in C/L road N. & S. & 30' S. of C/L of road to the East. No Harrison Marker set. Corner approved and accepted as found.

THIS GOVERNMENT MONUMENT WAS RESTORED WITH APPROVAL OF THE VAN BUREN COUNTY REMONUMENTATION PEER GROUP OF SURVEYORS AT A MEETING HELD ON FEBRUARY 24, 1993, AND IS ACCEPTED AS A CAREFUL AND FAITHFUL PERPETUATION OF THE POSITION OF THE ORIGINAL CORNER.

C. Description of monument for corner and accessories established to perpetuate locating the position of the corner:

G-7 M.D.S.H. BRONZE CAP IN MONUMENT BOX

- N.35°E. 63.47' PK nail in SE face of pole.
- N.25°W. 61.00' set nail & tag in E. face of 18" Maple.
- N.88°E. 50.00' set nail & tag in S. face pole.
- S.20°W. 44.24' set nail & tag in NW face of pole.

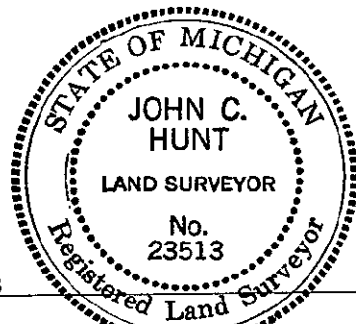

Signed by John C. Hunt
Surveyor's Michigan License No. 23513

Date Oct. 17, 1993