

JAN 14 1998

LAND CORNER RECORDATION CERTIFICATE
Filing Requirement of Act 74, Mich. P.A. 1970
VAN BUREN COUNTY REMONUMENTATION

Dec 23 8 58 AM '97

SECTION

For corners in

VAN BUREN

(County)

Located In:

Corner Code #

1. Public Land Survey
S 1/4 COR, SEC. 35
DECATUR TWP.

T 4S R 14W

J-13

2. Property Controlling
in Section

3. Miscellaneous

Property in Sec.

S

S

S

S

T

T

T

T

R

R

R

R

Mark A. Smith
VAN BUREN CO.
REGISTERED SURVEYOR

Liber 5 Page 90

Register of Deeds Stamp & File Number

4. Lot No. _____, Recorded Plat _____

5. Private Claims _____

I, DALE L. KESLER, in a field survey on NOV. 28, 1997 do hereby state that under requirements of P.A. 74, Michigan P.A. of 1970, the corner points mentioned in lines 1 and 2 above were in conformance with regulations and rules therefore as required in the current manual of survey instructions of the United States Department of the Interior, Bureau of Land Management or by a decree of a Court of Law and/or that the corner points mentioned in lines 3, 4 and 5 above were in conformance with the rules of the Michigan Board of Land Surveyors or by a Decree of a Court of Law; established, re-established, monumented, recovered, found as expressed below:

NOTE: Not more than 2 corners, all in the same town and range, may be recorded on this certificate.

A. Description of original monument and accessories and/or subsequent restoration:

*1827 WILLIAM BROOKFIELD. SET QUARTER SECTION POST. 12" BURR OAK N 25 1/3 DEGREES W 15.86 LKS., 12" BURR OAK N 2 1/2 DEGREES W 17.63 LKS.

*AUG. 30, 1905 J.S. HAINES (CASS COUNTY SURVEYOR), ESTABLISHED HALF WAY PIPE. 8" ELM S 60 3/4 DEGREES E 51 2/3 LKS., 14" CHERRY N 72 3/4 DEGREES W 97 LKS.

*SEPT. 15, 1941 T.A. SMITH. MEASURED SOUTH LINE OF THE SW 1/4, SECTION 35 - 2645.85'.

	A	B	C	D	E	F	G	H	I	J	K	L	M
1													
2	6		5		4		3		2		1		
3													
4	7		8		9		10		11		12		
5													
6	18		17		16		15		14		13		
7													
8	19		20		21		22		23		24		
9													
10	30		29		28		27		26		25		
11													
12	31		32		33		34		35		36		
13													

B. Description of corner evidence found and/or method applied in restoring or reestablishing corner:

CORNER NOT FOUND. REESTABLISHED CORNER AT THE MIDWAY POINT BETWEEN THE SW CORNER OF SECTION 35, T4S, R14W, AND THE SE CORNER OF SECTION 35, T4S, R14W, DECATUR TOWNSHIP, VAN BUREN COUNTY, MICHIGAN. APPROVED AT THE DECEMBER 3, 1997 VAN BUREN COUNTY PEER GROUP MEETING AND IS ACCEPTED AS A CAREFUL AND FAITHFUL REESTABLISHMENT OF THE POSITION OF THE ORIGINAL CORNER.

C. Description of monument for corner and accessories established to perpetuate locating the position of the corner:

SET HARRISON MARKER IN MONUMENT BOX.


P.K. NAIL & BOTTLECAP IN POWER POLE N 31 DEGREES 36' 50" E 39.05'

R.R. RAIL POST S 5 DEGREES 35' 40" E 28.68'

NAIL & TAG 12" CHERRY TREE S 10 DEGREES 35' E 50.87'

NAIL & TAG POWER POLE N 84 DEGREES 07' W 300.07'

C.L. EAST & WEST ROAD NORTH 3.00'

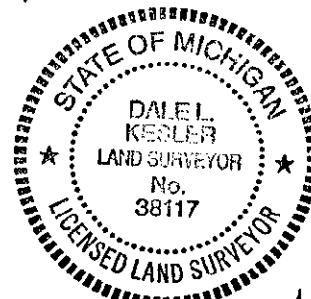

Signed by

Dale L. Kesler

Date

12/2/97

Surveyor's Michigan License No.

38117

Ratified by Peer Group in
accordance with P.A. 345 of 1990
Van Buren County Surveyor

Date D. R. A. 12/23/97