

FEB 23 1994

RC 1208

27003-586

COMMISSION

LAND CORNER RECORDATION CERTIFICATE  
Filing Requirement of Act 74, Mich. P.A. 1970

For corners in

WAYNE

(County)

Located In:

Corner Code ##

1. Public Land Survey T 1 S R 8 E C 7  
T \_\_\_\_\_ R \_\_\_\_\_  
T \_\_\_\_\_ R \_\_\_\_\_  
T \_\_\_\_\_ R \_\_\_\_\_
2. Property Controlling S \_\_\_\_\_ T \_\_\_\_\_ R \_\_\_\_\_  
in Section S \_\_\_\_\_ T \_\_\_\_\_ R \_\_\_\_\_
3. Miscellaneous S \_\_\_\_\_ T \_\_\_\_\_ R \_\_\_\_\_  
Property in Sec. S \_\_\_\_\_ T \_\_\_\_\_ R \_\_\_\_\_

Register of Deeds Stamp & File Number

4. Lot No. \_\_\_\_\_, Recorded Plat \_\_\_\_\_  
5. Private Claims \_\_\_\_\_

I, PAUL V. SCHWIMMER, in a field survey on NOVEMBER 2, 19 93, do hereby certify that under requirements of P.A. 74, Michigan P.A. of 1970, the corner points mentioned in lines 1 and 2 above were in conformance with regulations and rules therefore as required in the current manual of survey instructions of the United States Department of the Interior, Bureau of Land Management or by a decree of a Court of Law and/or that the corner points mentioned in lines 3, 4 and 5 above were in conformance with the rules of the Michigan Board of Land Surveyors or by a Decree of a Court of Law; established, re-established, monumented, re-monumented, recovered, found as expressed below:

NOTE: Not more than 4 corners, all in the same town and range, may be recorded on this certificate.

A. Description of original monument and accessories and/or subsequent restoration:

NO G.L.D. WITNESSES REMAIN, A POST WAS SET BY JOSEPH WAMPLER IN THE ORIGINAL SURVEY OF THE TOWNSHIP WHICH WAS COMPLETED MARCH 14, 1816.

B. Description of corner evidence found and/or method applied in restoring or reestablishing corner:  
PREVIOUSLY RECORDED IN:

1972 LIBER 18145, PG 273  
MONUMENT IN BOX IN ASPHALT PAVEMENT  
NW 72.73' SPIKE IN D.E. GUY POLE (MEAS 72.64')  
NE 74.29' SPIKE IN D.E. POLE (MEAS 74.09')  
SE 48.03' CENTER OF MANHOLE COVER (NOT RECOVERED)  
SW 86.14' BRASS TAG IN FENCE POST (NOT RECOVERED)

NOTE: NO BUREAU OF TAXATION WITNESSES REMAIN (1930)

1975 LIBER 19026, PG 906  
CONCRETE MONUMENT IN BOX  
NW 72.70' SPIKE IN NW SIDE OF D.E. POLE (MEAS 72.73')  
NE 74.15' SPIKE IN SE SIDE D.E. POLE (MEAS 74.09')  
SE 47.20' "X" CUT IN W. RIM OF MANHOLE COVER (NOT RECOVERED)

WAYNE CO. RD. COMM 1975  
FOUND CONC. MONUMENT IN MON. BOX  
NE 74.15' D.E. POLE (MEAS 74.09')  
SE 47.20' "X" IN W. RIM MANHOLE (NOT RECOVERED)  
NW 72.70' GUY POLE (MEAS 72.64')

C. Description of monument for corner and accessories established to perpetuate locating the position of the corner:

FOUND CONC. MONUMENT IN MONUMENT BOX AT "X" OF FIVE MILE AND RIDGE ROAD  
N 45° E 74.09' SET NAIL & TAG IN SE SIDE OF POWER POLE (PREVIOUS WITNESS)  
S 20° E 152.24' SET NAIL & TAG IN W SIDE OF POWER POLE  
S 60° W 139.63' SET NAIL & TAG IN SE SIDE 12" TWIN ELM  
N 80° W 202.32' SET NAIL & TAG IN S SIDE 18" ELM  
N 45° W 72.64' SET NAIL & TAG IN SW SIDE POWER POLE (PREVIOUS WITNESS)


DISTANCE TO B 7 MEASURED AS 2643.21' RECORDED IN 1930 AS 2642.69'  
DISTANCE TO C 6 MEASURED AS 2547.97' RECORDED IN 1930 AS 2547.81'  
SET REMONUMENTATION DISC AND CAP ON MONUMENT

THE SELECTED LOCATION IS A CAREFUL AND FAITHFUL PERPETUATION OF THE POSITION OF THE ORIGINAL CORNER

Signed by Paul V. Schwimmer

Date NOVEMBER 8, 1993

Surveyor's Michigan License No. 24618

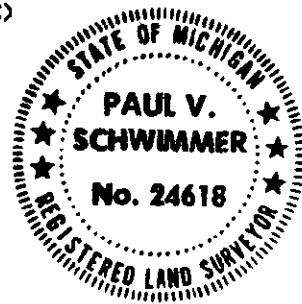

2R  
11KD