

RC 1188

LAND CORNER RECORDATION CERTIFICATE
Filing Requirement of Act 74, Mich. P.A. 1970

LI 26992 PA 875

For corners in

Wayne
(County)

Located In:
City of Detroit

OTHER
Corner Code ##

1. Public Land Survey

T 15 R 13E# 003

T _____ R _____

T _____ R _____

T _____ R _____

2. Property Controlling
in Section

S _____ T _____ R _____

S _____ T _____ R _____

3. Miscellaneous
Property in Sec.

S _____ T _____ R _____

S _____ T _____ R _____

Compliance with
ACT 345, P.A. 1990

APPROVED ON: 11-18-93 DBL
WAYNE COUNTY REMONUMENTATION
PEER GROUP COMMITTEE

Register of Deeds Stamp & File Number

4. Lot No. _____, Recorded Plat _____

5. Private Claims P.C. corner common to 123, 241, and 404
Centerline - Centerline of Canyon Ave. and Moran Rd.

I, Steven E. Dunn, in a field survey on November 8, 1993,
do hereby certify that under requirements of P.A. 74, Michigan P.A. of 1970, the corner points mentioned
in lines 1 and 2 above were in conformance with regulations and rules therefore as required in the
current manual of survey instructions of the United States Department of the Interior, Bureau of Land
Management or by a decree of a Court of Law and/or that the corner points mentioned in lines 3, 4 and 5
above were in conformance with the rules of the Michigan Board of Land Surveyors or by a Decree of a
Court of Law; established, re-established, monumented, re-monumented, recovered, found as
expressed below:

NOTE: Not more than 4 corners, all in the same town and range, may be recorded
on this certificate.

A. Description of original monument and accessories and/or subsequent restoration:
No GLO Witnesses remain

GLO original survey of Private Claims 123, 241, & 404 by Aaron Greeley Jan 4, 1810

GLO survey of concessions and intersecting lines by John Mullett, Dec. 1923 - Nov. 1924

B. Description of corner evidence found and/or method applied in restoring or reestablishing corner:
No evidence found

Reestablished location using found irons with reference to plats Mack-Seven Mile Sub.,
as recorded in L.55, P.97 (W.C.R.) and Roland Estate Sub., as recorded in L.56, P.16 (W.C.R)

Placed Wayne County Remonumentation marker and plastic cap #28408 on 1/2" X 18" iron
within a monument box.

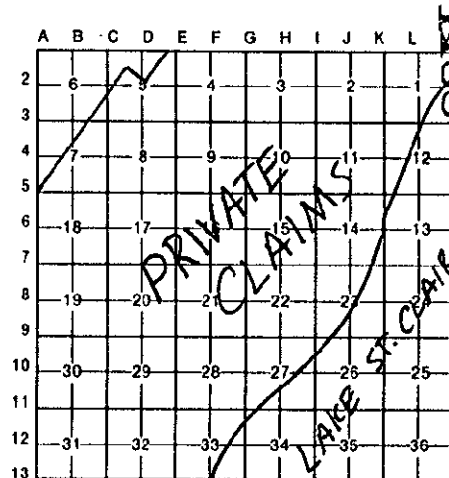
C. Description of monument for corner and accessories established to perpetuate locating the position of the corner:

Wayne County Remonumentation marker and plastic cap #28408 on 1/2" X 18" iron within a
monument box.

Witnesses

- Set P.K. Nail and W.C.R. witness tag in N'ly root of 14" Oak S.78°W - 46-95'
- Set P.K. Nail and W.C.R. witness tag in W'ly root of 19" Oak S.07°W - 65.82'
- Set P.K. Nail and W.C.R. witness tag in N'ly face of 5" Oak N.58°E - 45.41'
- Set P.K. Nail and W.C.R. witness tag in W'ly face of 11" Maple N.10°W - 24.57'

The selected location is a careful and faithful reestablishment of the position of the
original corner

Signed by Steven E. DunnDate Nov. 30, 1993Surveyor's Michigan License No. 28408

33 NOV 30 PM 4:25
FOREST E. YOUNGBLOOD
REGISTER OF DEEDS
WAYNE COUNTY, MI



21
117