

RC 1191

**LAND CORNER RECORDATION CERTIFICATE**  
**Filing Requirement of Act 74, Mich. P.A. 1970**

LI 26992 PA 878

For corners in

Wayne  
 (County)

Located In:

City of Detroit

OTHER

Corner Code #

1. Public Land Survey

T 15 R 13E0006

T \_\_\_\_\_ R \_\_\_\_\_

T \_\_\_\_\_ R \_\_\_\_\_

T \_\_\_\_\_ R \_\_\_\_\_

2. Property Controlling  
in Section

S \_\_\_\_\_ T \_\_\_\_\_ R \_\_\_\_\_

S \_\_\_\_\_ T \_\_\_\_\_ R \_\_\_\_\_

3. Miscellaneous  
Property in Sec.

S \_\_\_\_\_ T \_\_\_\_\_ R \_\_\_\_\_

S \_\_\_\_\_ T \_\_\_\_\_ R \_\_\_\_\_

Compliance with  
 ACT 345, P.A. 1990

APPROVED ON: 11-18-93 DDJ  
 WAYNE COUNTY REMONUMENTATION  
 PEER GROUP COMMITTEE

Register of Deeds Stamp &amp; File Number


4. Lot No. \_\_\_\_\_, Recorded Plat \_\_\_\_\_

5. Private Claims Point on line between P.C.'s 692 & 695  
On centerline Mack Ave. between Outer Drive and Kensington

I, Steven E. Dunn, P.S. in a field survey on November 16, 19 93,  
 do hereby certify that under requirements of P.A. 74, Michigan P.A. of 1970, the corner points mentioned  
 in lines 1 and 2 above were in conformance with regulations and rules therefore as required in the  
 current manual of survey instructions of the United States Department of the Interior, Bureau of Land  
 Management or by a decree of a Court of Law and/or that the corner points mentioned in lines 3, 4 and 5  
 above were in conformance with the rules of the Michigan Board of Land Surveyors or by a Decree of a  
 Court of Law; established, re-established, monumented, re-monumented, recovered, found as  
 expressed below:

NOTE: Not more than 4 corners, all in the same town and range, may be recorded  
 on this certificate.

A. Description of original monument and accessories and/or subsequent restoration:  
 No corner set in original government survey.

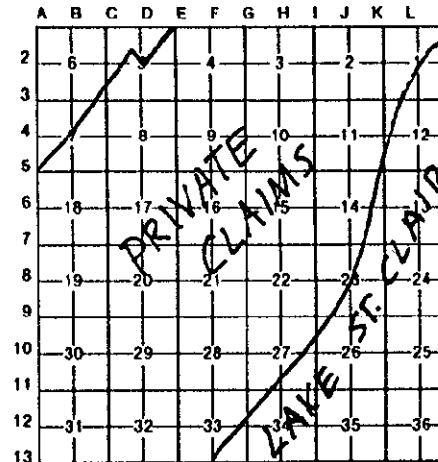

B. Description of corner evidence found and/or method applied in restoring or reestablishing corner:  
 No evidence of corner found.

Established point on line between PC's 692 and 695 with reference to "Scripps Grosse  
 Pointe Park Subdivision", as recorded in L.58,P.87 of plats (W.C.R.) and "Wallace  
 Bros. Kensington Road Park Sub'n." as recorded in L.33,P.84 of Plats (W.C.R.), using  
 found monuments and back of curb and back of walk splits.

Placed Wayne County Remonumentation marker and plastic cap #28408 on 1/2" X 18"  
 Iron within a monument box.

C. Description of monument for corner and accessories established to perpetuate locating the position of the corner:  
 Wayne County Remonumentation marker and plastic cap #28408 on 1/2" x 18" iron  
 within a monument box.

Witnesses

- Set P.K. Nail and W.C.R. witness tag on top concrete curb
- Set P.K. Nail and W.C.R. witness tag on top concrete curb
- Set P.K. Nail and W.C.R. witness tag in W'ly face 23" Elm
- Set P.K. Nail and W.C.R. Witness tag in W'ly face 28" Elm

N.72°W. - 35.42'.  
 N.18°E. - 41.75'.  
 S.89°E. - 65.08'.  
 S.10°W. - 57.35'.

The selected location for this Property Controlling Monument  
 is accepted as a careful and faithful determination of the position  
 as indicated.

Signed by Steven E. DunnDate Nov. 30, 1993Surveyor's Michigan License No. 28408

33 NOV 30 PM 4:25  
 FOREST COUNTY RECORDS  
 REGISTER OF DEEDS  
 JEFFERSON COUNTY, MI