

RC 1156

LAND CORNER RECORDATION CERTIFICATE
Filing Requirement of Act 74, Mich. P.A. 1970

1133992 PA 840

For corners in

Wayne
 (County)

Located in: DEARBORN ^{OTHER} Corner Code ##

- | | | |
|-------------------------|----------------------------|-----------|
| 1. Public Land Survey | T <u>2 S</u> R <u>10 E</u> | <u>#1</u> |
| | T _____ R _____ | _____ |
| | T _____ R _____ | _____ |
| | T _____ R _____ | _____ |
| 2. Property Controlling | S _____ T _____ R _____ | _____ |
| in Section | S _____ T _____ R _____ | _____ |
| 3. Miscellaneous | S _____ T _____ R _____ | _____ |
| Property in Sec. | S _____ T _____ R _____ | _____ |

Compliance with
 ACT 345, P.A. 1990

APPROVED ON: 11-30-93 DBL
 WAYNE COUNTY REMONUMENTATION
 PEER GROUP COMMITTEE

Register of Deeds Stamp & File Number

4. Lot No. _____, Recorded Plat _____
5. Private Claims Corner on line between PC 31 & PC 142
Easterly Right-of-Way of M-39 (Southfield
T 2 S, R 10 E Freeway)

Lawrence R.

I, Feindt, in a field survey on November 4, 19 93,
 do hereby certify that under requirements of P.A. 74, Michigan P.A. of 1970, the corner points mentioned
 in lines 1 and 2 above were in conformance with regulations and rules therefore as required in the
 current manual of survey instructions of the United States Department of the Interior, Bureau of Land
 Management or by a decree of a Court of Law and/or that the corner points mentioned in lines 3, 4 and 5
 above were in conformance with the rules of the Michigan Board of Land Surveyors or by a Decree of a
 Court of Law; established, re-established, monumented, re-monumented, recovered, found as
 expressed below:

**NOTE: Not more than 4 corners, all in the same town and range, may be recorded
 on this certificate.**

- A. Description of original monument and accessories and/or subsequent restoration:
Corner on Line Common to Private Claims 31 and 142, T 2 S, R 10 E
at the Easterly Right-of-Way of the Southfield Freeway (M-39)

Found 4" x 36" concrete monument.

N10°E-17.31'-PK nail in W'ly side of 6" tree

S30°E-30.22'-60d spike N'ly side 36" Oak

S05°W-66.07'-Chiseled "+" in top of curb east side of the east service drive M-39

N30°W-20.73'-Chiseled "+" in top of curb east side of the east service drive M-39

September 15, 1992 by Bruce Antcliff, PS #25826, recorded in Liber 26070, Page 567, WCR

- B. Description of corner evidence found and/or method applied in restoring or reestablishing corner:
Corner on Line Common to Private Claims 31 and 142, T 2 S, R 10 E
at the Easterly Right-of-Way of the Southfield Freeway (M-39)

Found concrete monument with top 9" broken off. Checked
 monument location with irons found and documented per survey
 for Williams & Works (Ford Motor Land Development), survey
 no. 88-017, revised 5/31/88, and prepared by George B.
 Warnke, PS. A copy of the survey was furnished by Bruce
 Antcliff, PS #25826, of WW Engineering & Science - Allen
 Park, Michigan, on August 27, 1993. The monument witnessed
 by Bruce Antcliff, PS #25826, as recorded in Liber 26070,
 Page 567, WCR (RC 1058) was incorrect, and was found to be
 1.59' South and 0.15' West of the correct monument as
 documented on said survey.

- C. Description of monument for corner and accessories established to perpetuate locating the position of the corner:
Corner on Line Common to Private Claims 31 and 142, T 2 S, R 10 E
at the Easterly Right-of-Way of the Southfield Freeway (M-39)


Found concrete monument with top 9" broken off. This position not established by original
 government surveyors. This monument is accepted as the best available evidence of the
 position of the corner.

Witnesses: S08°W - 1.60' - Concrete monument with top 9" broken off
 S54°E - 30.81' - 60d spike in N'ly side of 60" Oak
 N20°E - 81.90' - Set PK nail with Wayne County brass disk stamped with license
 #21566 in W'ly side of 12" Oak
 N53°W - 20.09' - Found chiseled "+" cut in curb
 S18°W - 67.58' - Found chiseled "+" cut on curb

Signed by Lawrence R. Feindt Date November 29, 1993

Surveyor's Michigan License No. 21566

	A	B	C	D	E	F	G	H	I	J	K	L	M
2	6	5	4	3	2	1							
3													
4	7	8	9	10	11	12							
5													
6	18	17	16	15	14	13							
7													
8	19	20	21	22	23	24							
9													
10	30	29	28	27	26	25							
11													
12	31	32	33	34	35	36							
13													

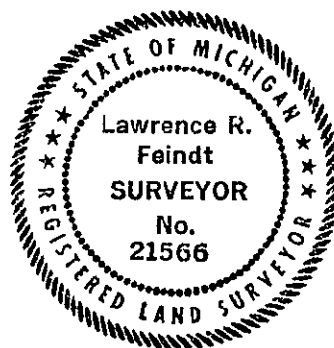

2R
 11K