

LI29867PA016

\$ 4.00 REMONUMENTATION

30 DEC 96 1:49 P.M.

RECEIPT# 469

LAND CORNER RECORDATION CERTIFICATE

Filing Requirement of Act 74, Mich. P.A. 1970

RECORDED

FOREST E. YOUNGBLOOD, REGISTER OF DEEDS
WAYNE COUNTY, MI

For corners in

\$ 7.00 DEED

Wayne, Van Buren Twp.

Located In:

Corner Code #

(County)

1. Public Land Survey

T 3S. R 8E.

M-9

T R

T R

T R

T R

2. Property Controlling
in Section

S

T R

S

T R

3. Miscellaneous
Property in Sec.

S

T R

S

T R

Compliance with
ACT 345, P.A. 1990APPROVED ON: 12-30-96
WAYNE COUNTY REMONUMENTATION
PEER GROUP COMMITTEE

Register of Deeds Stamp & File Number

4. Lot No. _____, Recorded Plat _____

5. Private Claims _____

I, William L. Roskelly, in a field survey on Dec 16, 19 96, do hereby state that under requirements of P.A. 74, Michigan P.A. of 1970, the corner points mentioned in lines 1 and 2 above were in conformance with regulations and rules therefore as required in the current manual of survey instructions of the United States Department of the Interior, Bureau of Land Management or by a decree of a Court of Law and/or that the corner points mentioned in lines 3, 4 and 5 above were in conformance with the rules of the Michigan Board of Land Surveyors or by a Decree of a Court of Law; established, re-established, monumented, recovered, found as expressed below:

NOTE: Not more than 2 corners, all in the same town and range, may be recorded on this certificate.

	A	B	C	D	E	F	G	H	I	J	K	L	M
1													
2	6			5			4			3		2	1
3													
4	7			8			9			10		11	12
5													
6	18			17			16			15		14	13
7													
8	19			20			21			22		23	24
9													
10	30			29			28			27		26	25
11													
12	31			32			33			34		35	36
13													

A. Description of original monument and accessories and/or subsequent restoration:

M-9) Southeast corner section 24, T.3 S., R.8 E., Van Buren Township

G.L.O. (1830's) J. Wampler set corner post, witnesses: Ash 18 S 66 E 15 (gone), Lynn 18 N 33 W 30 (gone).

W.P.A. (1930's) Set an iron, witnesses: N. 44.31' nail in tree (gone), SE 65.18' nail in a 10" Oak (gone), SW 37.67' nail in a Ed. pole (gone), W 33.44' iron (gone), NW 48.59' nail in a 20" Oak (gone).

No RC's or CS's found on file at Wayne County.

B. Description of corner evidence found and/or method applied in restoring or reestablishing corner:

M-9) Southeast corner section 24, T.3 S., R.8 E., Van Buren Township

Found a bent iron pipe, replaced with steel bar Hannan Road (gravel).

Verified corner position by comparing field measurements with W.P.A. survey:


Distance M-9 to M-8 Record = 2661.48' Measured = 2660.72'

Distance M-9 to M-10 Record = 2653.63' Measured = 2653.74'

Angle line M-9 & M-8 to M-9 & M-10 Record = 178° 14' 20" Measured = 179° 46' 20"

Measured 1023.64' from M-9 to A-9 Romulus Township.

NOT A COMMON CORNER.

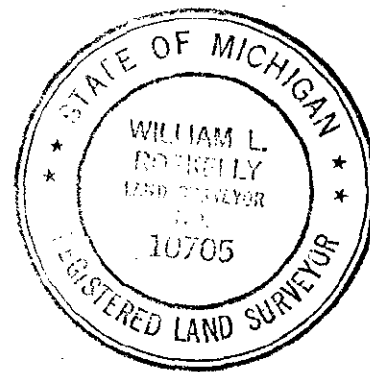

C. Description of monument for corner and accessories established to perpetuate locating the position of the corner:

M-9) Southeast corner section 24, T.3 S., R.8 E., Van Buren Township

Found a bent iron pipe, replaced with steel bar Hannan Road (gravel).

The selected location is accepted by the contractor and is generally accepted by professional surveyors as the best available evidence of the position of the corner.

WITNESSES:

N. 67° E. 40.01' set nail WCR tag S. face 24" Oak, S. 18° E. 93.93' set nail WCR tag W. face 24" Oak, S. 18° E. 93.89' found P.K. nail W. face 24" Oak, S. 50° W. 40.54' found P.K. nail and W.C.R. tag S.E. face power pole, W. 90° 36.47' found iron pipe, N.

30° W. 51.72' set nail W.C.R. tag S.W. face 36" Oak.

Placed Wayne County Remonumentation brass marker and cap #10705.

Signed by

Date

12-30-96

Surveyor's Michigan License No. 10705