

FILE DO NOT MAIL

For corners in

LAND CORNER RECORDATION CERTIFICATE
Filing Requirement of Act 74, Mich. P.A. 1970

Wayne
(County)

Located In:
Grosse Ile Twp.

Corner Code #

Liber-30864. Page-21
99595872 12/30/1999
F.E. Youngblood, Wayne Co. Register of Deeds

1. Public Land Survey

T R
T R
T R
T R

2. Property Controlling
in Section

S T R
S T R

3. Miscellaneous
Property in Sec.

S PC T 4 S R 11 E
S T R

OTHER CODE
5

Compliance with
ACT 345, P.A. 1990

APPROVED ON: 12-8-99
WAYNE COUNTY REMONUMENTATION
PEER GROUP COMMITTEE

Register of Deeds Stamp & File
Number

4. Lot No. , Recorded Plat

550/551

5. Private Claims ~~553/554~~ int. of Park Lane and Church Road in Grosse Ile Twp.

I, Michael S. Hoben, in a field survey on Sept. 22, 1999 do hereby state that under requirements of P.A. 74, Michigan P.A. of 1970, the corner points mentioned in lines 1 and 2 above were in conformance with regulations and rules therefore as required in the current manual of survey instructions of the United States Department of the Interior, Bureau of Land Management or by a decree of a Court of Law and/or that the corner points mentioned in lines 3, 4 and 5 above were in conformance with the rules of the Michigan Board of Land Surveyors or by a Decree of a Court of Law; established, re-established, monumented, recovered, found as expressed below:

NOTE: Not more than 2 corners, all in the same town and range, may be recorded on this certificate.

A. Description of original monument and accessories and/or subsequent restoration:


Private Claim 1810 Greely
Private Plat
Supervisor's Plat No. 3 Kruba
Grosse Ile Plat No. 5 (1940) Daquest
Rossin-Ringle Sub No. 1 (1955) Salle
LCRC 1994 Condon
LCRC 1995 Wilkerson

RECORDED
FEB 28 2000

SECTION

B. Description of corner evidence found and/or method applied in restoring or reestablishing corner:

We establish this corner from found property corners in Grosse Ile Plat No 8, Grosse Ile Plat No. 53 and Rossin-Ringle No. 1 as shown on sketch below.

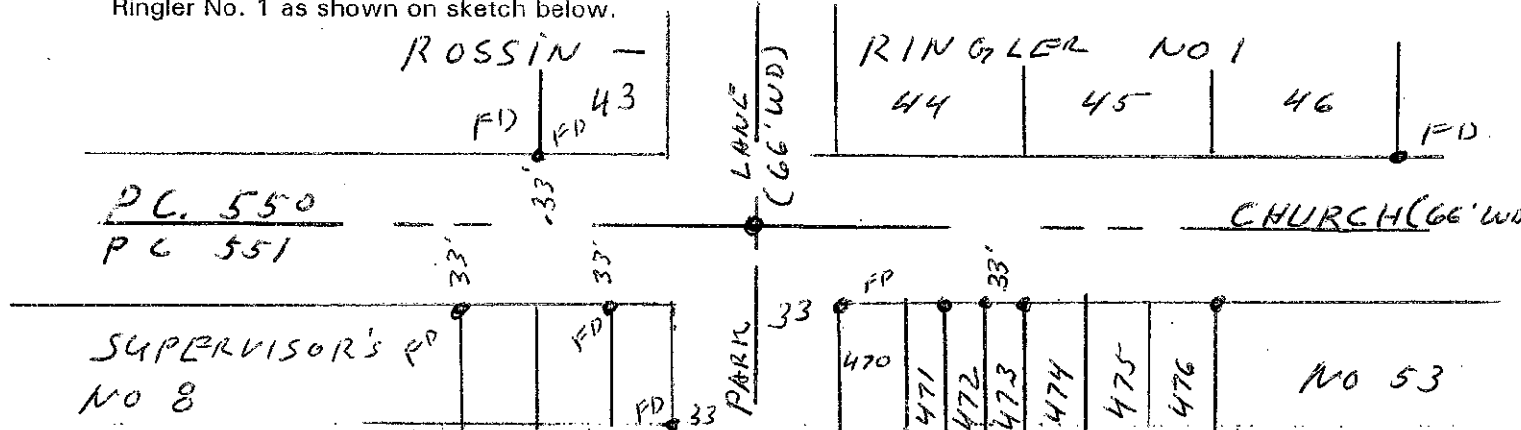

B. Description of monument for corner and accessories established to perpetuate locating the position of the corner:

I set a 2" aluminum cap stamped "Wayne County Monument MI Act 345 #35994" on the rebar in a new monument box.

N 45°E 67.83' Set Nail and W.C. Remon. Tag on W side of guy pole
N 45°W 35.02' Set Nail and W.C. Remon. Tag in SE'ly face Util. pole
S 50°W 31.84' Set Nail and W.C. Remon. Tag in SW side of 16" tree
S 45°E 94.30' Top bolt Hyd

The selected location for this Property Controlling Monument is accepted as a careful and faithful determination of the position as indicated.

Signed by

Michael S. Hoben

Date

Dec 27/1999

Surveyor's Michigan License No. 35994

FORM APPROVED BY MICHIGAN STATE BOARD OF LAND SURVEYORS, JAN. 28, 1971

REVISED MAY 14, 1975
REVISED JAN., 1983
REVISED OCT., 1999

R LCR 9 4R 1pg A DR