

MAY 10 2000

SECTION

LAND CORNER RECORDATION CERTIFICATE
Filing Requirement of Act 74, Mich. P.A. 1970

For corners in

WEXFORD COUNTY

Located In:

Corner Code #

1. Public Land Survey

T 21N R 09W

I-4

2. Property Controlling
in Section

S

T

R

S

T

R

3. Miscellaneous
Property in Sec.

S

T

R

S

T

R

1999 DEC - 1 PM 3:06
WEXFORD COUNTY, MI
REGISTER OF DEEDS

RECEIVED

Register of Deeds Stamp & File Number

4. Lot No. , Recorded Plat

5. Private Claims

I, George D. Smith, P.S., in a field survey on June, 19 99 do hereby state that under requirements of P.A. 74, Michigan P.A. of 1970, the corner points mentioned in lines 1 and 2 above were in conformance with regulations and rules therefore as required in the current manual of survey instructions of the United States Department of the Interior, Bureau of Land Management or by a decree of a Court of Law and/or that the corner points mentioned in lines 3, 4 and 5 above were in conformance with the rules of the Michigan Board of Land Surveyors or by a Decree of a Court of Law; established, re-established, monumented, recovered, found as expressed below:

NOTE: Not more than 2 corners, all in the same town and range, may be recorded on this certificate.

A. Description of original monument and accessories and/or subsequent restoration:

- I-4) 1848 GLO Subdivision by Orson Lyon D.S. Hemlock 20-N32½E-22, Sugar Tree 14-N78½W-26.
1886 A. Teed Survey Liber 1, Page 16. Corner found no description or witnesses given.
1906 D. Teed Survey Liber 1, Page 15. No stake at corner, witness stake is 40 feet north.
1981 McClung PS #13037 LCRC Liber 3, Page 247. Monument box in east-west roads, no witnesses given.
1985 Ray PS #24869 Certificate of Survey Liber 2, Page 161. Found 1" iron in monument box. S40W-Powerpole-75.33, N20E-Powerpole-131.90, North to east-west centerline bit 1.5.
1990 Carlson PS #24589 LCRC Liber 4, Page 69. Found 1" iron pine in monument box. Tw 8" apple-S66E-143.75, Powerpole-S44W-75.32, Triple 4" box elder-N56W-69.11, Service pole-N22E-131.35.
1992 Ray PS #24869 Certificate of Survey Liber 75, Page 373. Found 1" belt in monument box, witnesses same as 1985 Certificate of Survey.
1997 Smith PS #39098 LCRC Liber 5, Page 16. Found 1" iron in monument box. N57E-54.22-10" S. pine, N60W-68.95-8" box elder, S43W-72.84-Powerpole, S47E-48.44-set iron.
1998 Pullen PS #39095 Certificate of Survey Liber 78, Page 369. Found 1" bolt in monument box. N18E-Powerpole-131.38, N9W-Powerpole-160.11, S15W-Powerpole-120.78, S12E-14" maple-172.90.
1999 Schripsema PS #24617 LCRC Liber 5, Page 152. Found 1/2" iron in monument box, replaced with 1/2" iron with cap after completion of road construction.

B. Description of corner evidence found and/or method applied in restoring or reestablishing corner:

- I-4) Found ½" iron with cap #24617 in monument box and one witness from 1995 Ray PS #24869 survey and one witness from 1998 Pullen PS #39095 survey. This corner is accepted as the best available evidence of the position of the original corner being the quarter corner common to Sections 10 and 11, T21N, R9W.

C. Description of monument for corner and accessories established to perpetuate locating the position of the corner:


- I-4) Replaced 1/2" iron with 5/8"x36" iron with Wexford County brass cap stamped 10, 11 1999 #39098.
N06W 159.74 Powerpole (1998 Pullen 160.11)
N22E 131.33 Powerpole (1985 Ray 131.90)
S65W 232.28 Powerpole
S18W 120.66 Powerpole

Peer Group Reviewed and Approved

Date: 12 Nov 99
Richard D. Wilcox
Richard D. Wilcox, Wexford County Surveyor

LIBER

05 PAGE 166

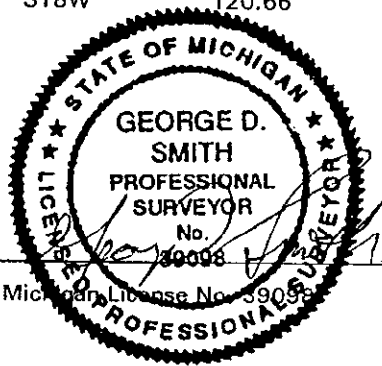

Signed by _____

Date 11-12-99

Surveyor's Michigan License No. 39098