

JAN 17 1996

COMMISSION

LAND CORNER RECORDATION CERTIFICATE
Filing Requirement of Act 74, Mich. P.A. 1970

RECEIVED

1995 NOV 13 PM 4:26

For corners in
WEXFORD

(County)

Located In:

Corner Code #

- | | | | | | |
|---------------------------------------|---|-----|---|-----|-----|
| 1. Public Land Survey | T | 21N | R | 11W | M-3 |
| | T | | R | | |
| | T | | R | | |
| | T | | R | | |
| 2. Property Controlling
in Section | S | | T | R | |
| | S | | T | R | |
| 3. Miscellaneous
Property in Sec. | S | | T | R | |
| | S | | T | R | |

Linda Loughmiller
WEXFORD COUNTY, MI
REGISTER OF DEEDS

Register of Deeds Stamp & File Number

4. Lot No. _____, Recorded Plat _____
5. Private Claims _____

I, CRAIG J. PULLEN, in a field survey on OCTOBER 5, 1995,
do hereby certify that under requirements of P.A. 74, Michigan P.A. of 1970, the corner points mentioned
in lines 1 and 2 above were in conformance with regulations and rules therefore as required in the
current manual of survey instructions of the United States Department of the Interior, Bureau of Land
Management or by a decree of a Court of Law and/or that the corner points mentioned in lines 3, 4 and 5
above were in conformance with the rules of the Michigan Board of Land Surveyors or by a Decree of a
Court of Law; established, re-established, monumented, re-monumented, recovered, found as
expressed below:

**NOTE: Not more than 4 corners, all in the same town and range, may be recorded
on this certificate.**

A. Description of original monument and accessories and/or subsequent restoration:

- M-3 1837 ORIGINAL G.L.O. SURVEY BY J. BRINK WOOD POST BEECH 10 S50 $\frac{1}{2}$ W 59 BEECH N47W 40
1902 DEVOE SURVEY IN SEC.6, T21N, R10W NO CORNER DESCRIPTION GIVEN. FENCE POST S44E 57
1903 D.E. TEED SURVEY IN SEC.1, T21N, R11W FOUND IRON PIPE AS PER DEVOE'S NOTES. THERE IS AN OLD BEECH STUMP TO NW BUT
IT IS 47 LINKS INSTEAD OF 40. THINK DEVOE MADE MISTAKE BUT I DID NOT TRY TO CORRECT IT. FENCE POST S44E 57
1977 ROAD COMMISSION WITNESS BOOK NO CORNER DESCRIPTION GIVEN 6" R.PINE S30 \circ E 67.90' 18" MAPLE S60 \circ E 79.40' P.POLE
N45 \circ W 47.30'
1980 USFS SURVEY BY R. GRIFFIN, PS #13584 REBAR P.POLE S65 \circ E 67.81' MAPLE 20" S71 \circ E 109.84' P.POLE N46 \circ W 47.35'
1988 J.L. WILCOX, PS #14102 L.C.R.C. L3, P.408 FOUND 5/8" IRON $\frac{1}{2}$ ' WEST OF N-S CENTERLINE AND $\frac{1}{8}$ ' SOUTH OF CENTERLINE E-W.
N47 \circ W P.POLE 47.31' S68 \circ E P.POLE 67.82' S16 \circ W 20" MAPLE 112.55' S54 \circ E 24" MAPLE 50.33'
1988 & 1994 WILCOX & ASSOC. SURVEYS L67, P.331 AND L.74, P.102 BY D. SCHRIPEMA, PS #24617 AND J.D. GEERS, PS #33977 RESPECTIVELY.
IRON N45 \circ W 47.29' POLE N45 \circ E 48.08' WOOD SIGN POST S50 \circ E 50.31' 24" MAPLE S18 \circ W 112.51' 24" MAPLE

B. Description of corner evidence found and/or method applied in restoring or reestablishing corner:

- M-3 FOUND $\frac{1}{2}$ " IRON IN OLD $\frac{1}{2}$ " PIPE IN CENTERLINE OF 25 RD. AND 5' SOUTH OF CENTERLINE OF WEST 40 RD. AND
3 PREVIOUS WITNESSES. REPLACED IRON AND PIPE WITH 5/8" X 36" IRON AND BRASS CAP. THIS MONUMENT
IS ACCEPTED AS A CAREFUL AND FAITHFUL REESTABLISHMENT OF THE POSITION OF THE ORIGINAL CORNER.



Peer Group Reviewed and Approved

Date: 19 Nov 95

Richard D. Wilcox
Richard D. Wilcox, Wexford County Surveyor

C. Description of monument for corner and accessories established to perpetuate locating the position of the corner:

- M-3
SECTION CORNER COMMON TO SECTIONS 1 AND
12, T21N, R11W AND SECTIONS 6 AND 7, T21N, R10W
5/8" X 36" IRON AND BRASS CAP STAMPED:
CJP, 39095, 1, 12, 6, 7, 1995
S18 \circ W 26" MAPLE 111.70'
N45 \circ W POWER POLE (CUT OFF) 47.29'
N81 \circ E POWER POLE 117.05'
S50 \circ E 26" MAPLE 50.31'

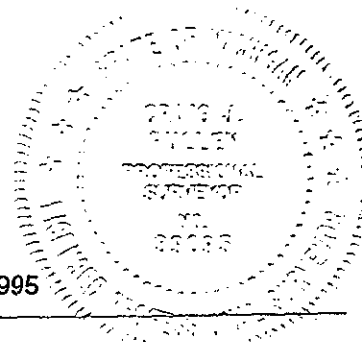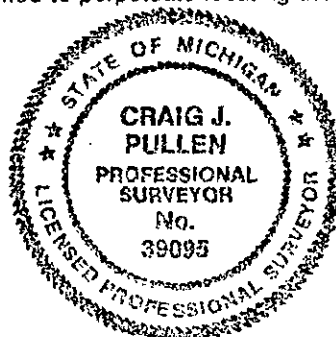

Signed by Craig J. Pullen Date NOVEMBER 9, 1995
Surveyor's Michigan License No. 39095