

EXHIBIT A  
CERTIFICATE

RECEIVED

JAN 17 1996

LAND CORNER RECORDATION CERTIFICATE  
Filing Requirement of Act 74, Mich. P.A. 1970

1995 NOV 13 PM 4: 27

For corners in  
WEXFORD

COMMISSION

Located In:

Corner Code M-8

*Linda Loughmiller*  
WEXFORD COUNTY, MI  
REGISTER OF DEEDS

1. Public Land Survey      T 21N R 11W      M-8  
   T      R  
   T      R  
   T      R  
2. Property Controlling      S      T      R  
   In Section                    S      T      R  
3. Miscellaneous              S      T      R  
   Property in Sec.            S      T      R  
4. Lot No. \_\_\_\_\_, Recorded Plat \_\_\_\_\_  
5. Private Claims \_\_\_\_\_

Register of Deeds Stamp & File Number

	A	B	C	D	E	F	G	H	I	J	K	L	M
2	6	5	4	3	2	1							
3													
4	7	8	9	10	11	12							
5													
6	18	17	16	15	14	13							
7													
8	19	20	21	22	23	24							
9													
10	30	29	28	27	26	25							
11													
12	31	32	33	34	35	36							
13													

I, CRAIG J. PULLEN in a field survey on SEPTEMBER 16, 1995,  
do hereby certify that under requirements of P.A. 74, Michigan P.A. of 1970, the corner points mentioned  
in lines 1 and 2 above were in conformance with regulations and rules therefore as required in the  
current manual of survey instructions of the United States Department of the Interior, Bureau of Land  
Management or by a decree of a Court of Law and/or that the corner points mentioned in lines 3, 4 and 5  
above were in conformance with the rules of the Michigan Board of Land Surveyors or by a Decree of a  
Court of Law, established, re-established, monumented, re-monumented, recovered, found as  
expressed below:

NOTE: Not more than 4 corners, all in the same town and range, may be recorded  
on this certificate.

A. Description of original monument and accessories and/or subsequent restoration:

M-8 1837 GLO SURVEY BY J. BRINK, WOOD POST B. ASH 10 S21W 14 B. ASH 10 N33W 19  
1895 A.J. TEED SURVEY IN SEC.24 NO CORNER DESC. CEDAR 12 S50W 21  
1904 D. TEED SURVEY IN SEC.24 NO CORNER DESC. CEDAR 14 S48W 22½ ASH 8 N89W 29 MAPLE 6 S42E 58½  
1973 WILCOX & ERICKSON SURVEY L.1, P.108 J. ERICKSON, PS #16929 L.C.R.C. L.2, P.548 SET WEXFORD COUNTY  
MONUMENT BY SINGLE PROPORTION. N30°E 38.78' 16" HEMLOCK N70°E 21.02' 10" MAPLE WEST 6'  
CENTERLINE N-S ROAD

B. Description of corner evidence found and/or method applied in restoring or reestablishing corner:

M-8 FOUND WEXFORD COUNTY MONUMENT IN POOR CONDITION 6' EAST OF CENTERLINE OF ROAD AND BOTH  
WITNESSES FROM 1973. REPLACED WEXFORD COUNTY MONUMENT WITH 5/8" X 36" IRON WITH BRASS CAP. THIS  
CORNER IS ACCEPTED AS A CAREFUL AND FAITHFUL RE-ESTABLISHMENT OF THE POSITION OF THE ORIGINAL  
CORNER, BEING THE ¼ CORNER COMMON TO SECTION 24, T24N, R11W, AND SECTION 19, T21N, R10W.


Peer Group Reviewed and Approved

Date: 10 Nov 95

*Richard D. Wilcox*  
Richard D. Wilcox, Wexford County Surveyor

C. Description of monument for corner and accessories established to perpetuate locating the position of the corner:

M-8 EAST ¼ CORNER, SECTION 24, T21N, R11W  
5/8" X 36" IRON WITH BRASS CAP STAMPED:  
CJP, 39095, 1995, ¼, 24, 19  
N34°E 24" HEMLOCK 38.78'  
N69°E 14" MAPLE STUMP 20.84'  
N42°W 3" MAPLE 50.22'  
S45°E 8" CEDAR 35.43'  
N47°E PHONE PEDESTAL GUARD POST 29.05'

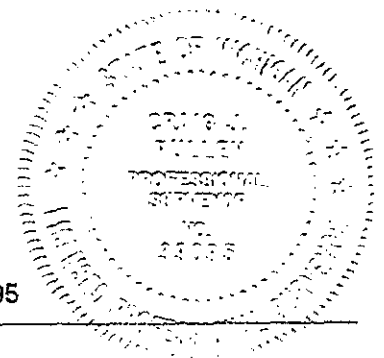

Signed by *Craig J. Pullen*

NOVEMBER 9, 1995

Surveyor's Michigan License No. 39095