

RECEIVED

JAN 17 1996

LAND CORNER RECORDATION CERTIFICATE 1995 DEC 21 AM 9:46

Filing Requirement of Act 74, Mich. P.A. 1970

For corners in
WEXFORD

COMMISSION

(County)

Located In:

Corner Code ##

Linda Loughmiller
WEXFORD COUNTY, MI
REGISTER OF DEEDS

- | | | | | | |
|---------------------------------------|---|-----|---|-----|------|
| 1. Public Land Survey | T | 21N | R | 11W | M-12 |
| | T | | R | | |
| | T | | R | | |
| | T | | R | | |
| 2. Property Controlling
in Section | S | | T | R | |
| | S | | T | R | |
| 3. Miscellaneous | S | | T | R | |
| Property in Sec. | S | | T | R | |

Register of Deeds Stamp & File Number

4. Lot No. _____, Recorded Plat _____
5. Private Claims _____

I, CRAIG J. PULLEN, in a field survey on DECEMBER 15, 1995, do hereby certify that under requirements of P.A. 74, Michigan P.A. of 1970, the corner points mentioned in lines 1 and 2 above were in conformance with regulations and rules therefore as required in the current manual of survey instructions of the United States Department of the Interior, Bureau of Land Management or by a decree of a Court of Law and/or that the corner points mentioned in lines 3, 4 and 5 above were in conformance with the rules of the Michigan Board of Land Surveyors or by a Decree of a Court of Law; established, re-established, monumented, re-monumented, recovered, found as expressed below:

NOTE: Not more than 4 corners, all in the same town and range, may be recorded on this certificate.

A. Description of original monument and accessories and/or subsequent restoration:

M-12 1837 ORIGINAL GLO SURVEY BY J. BRINK WOOD POST BEECH 10 S43W 55 BEECH 10 N72W 39

	A	B	C	D	E	F	G	H	I	J	K	L	M
2	6		5		4		3		2		1		
3													
4	7		8		9		10		11		12		
5													
6	18		17		16		15		14		13		
7													
8	19		20		21		22		23		24		
9													
10	30		29		28		27		26		25		
11													
12	31		32		33		34		35		36		
13													

B. Description of corner evidence found and/or method applied in restoring or reestablishing corner:


M-12 RAN LINE FROM NE CORNER SECTION 36, T21N, R11W TO SE CORNER SECTION 36, T21N, R11W, AND MADE MEASUREMENTS TO G.L.O. SURVEY CALLS (SWAMPS). NO CONCLUSIVE LOCATION COULD BE ARRIVED AT BY ANALYZING THE G.L.O. CALLS COMPARED TO CURRENT PHYSICAL FEATURES. SET 5/8" X 36" IRON AND BRASS CAP HALF WAY AND ON LINE BETWEEN NE CORNER AND SE CORNER SECTION 36. SEARCHED THIS LOCATION FOR G.L.O. EVIDENCE AND FOUND NONE. THIS CORNER IS ACCEPTED AS A CAREFUL AND FAITHFUL REESTABLISHMENT OF THE POSITION OF THE ORIGINAL CORNER.

Peer Group Reviewed and Approved

Date: 20 Dec 95
Richard D. Wilcox
Richard D. Wilcox, Wexford County Surveyor

C. Description of monument for corner and accessories established to perpetuate locating the position of the corner:

M-12 1/4 CORNER COMMON TO SECTION 36, T21N, R11W, AND SECTION 31, T21N, R10W
5/8" X 36" IRON AND BRASS CAP STAMPED: CJP, 39095, 1995, 1/4, 36, 31
S30°E 14" TWIN MAPLE 73.04'
S16°W 10" RED PINE 16.96'
S87°W 10" RED PINE 3.14'
N38°E 8" RED PINE 6.97'

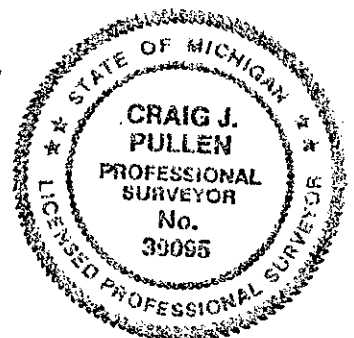

Signed by *Craig J. Pullen* Date DECEMBER 20, 1995
Surveyor's Michigan License No. 39095