

1998 DEC 30

RECEIVED

1998 DEC 30 PM 2: 12

SECTION

LAND CORNER RECORDATION CERTIFICATE
Filing Requirement of Act 74, Mich. P.A. 1970

Linda Longmiller
WEXFORD COUNTY, MI
REGISTER OF DEEDS

For corners in

Wexford Located In: Corner Code #
(County)

1. Public Land Survey T 23N R 10W M-12
T _____
T _____ *Common to:*
T _____

2. Property Controlling S _____ T _____
in Section S _____ T _____ *A-12 T23N, R9W*

3. Miscellaneous S _____ T _____
Property in Sec. S _____ T _____

Register of Deeds Stamp & File Number

4. Lot No. _____, Recorded Plat _____
5. Private Claims _____

I, George D. Smith, P.S., in a field survey on April 29, 1998 do hereby state that under requirements of P.A. 74, Michigan P.A. of 1970, the corner points mentioned in lines 1 and 2 above were in conformance with regulations and rules therefore as required in the current manual of survey instructions of the United States Department of the Interior, Bureau of Land Management or by a decree of a Court of Law and/or that the corner points mentioned in lines 3, 4 and 5 above were in conformance with the rules of the Michigan Board of Land Surveyors or by a Decree of a Court of Law; established, re-established, monumented, recovered, found as expressed below:

NOTE: Not more than 2 corners, all in the same town and range, may be recorded on this certificate.

A. Description of original monument and accessories and/or subsequent restoration:

- M-12) 1838 GLO Quarter Section Post by John Brink, Deputy Surveyor; Beech 8 S21W 30, Beech 8 N17 1/2 W 06
- M-12) 1883 A.J. Teed Survey Liber 1, Page 276. Corner found no desc. or witnesses provided.
- M-12) 1985 Mitchell PS# 28417 Cert. of Survey Liber 2, Pages 136. Set Wexford Co. Mon. N51W 12.66' 14" Beech, S43W 20.93' 14" Ash, S62W 23.90' 8" Beech, N87E 8.42' 6" Maple.
- M-12) 1988 Barnett PS#16923. Found Wexford Co. Mon. no witness given.

B. Description of corner evidence found and/or method applied in restoring or reestablishing corner:


Found Wexford Co. Mon. and 2 witnesses from 1985 Mitchell PS# 28417 Cert. of Survey. This corner is accepted as the best available evidence of the position of the original corner being the section corner common to Section 36 T23N-R10W and Section 31 T23N-R9W.

C. Description of monument for corner and accessories established to perpetuate locating the position of the corner:

Wexford Co. Mon. stamped PS 39098, 1998, E 1/4 36
S80E 8.47' 12" Maple (Mitchell 8.42')
N50W 12.70' 14" Beech (Mitchell 12.66')
S65W 20.76' 10" Beech
S45E 23.92' 16" Ash

Peer Group Reviewed and Approved

Date: December 1998
Richard D. Wilcox
Richard D. Wilcox, Wexford County Surveyor

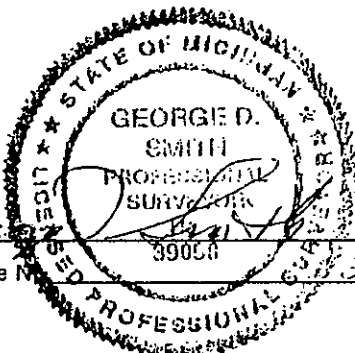

Signed by *George D. Smith*
Surveyor's Michigan License No. 39098

Date 12-9-98

FORM APPROVED BY MICHIGAN STATE BOARD OF PROFESSIONAL SURVEYORS, JAN. 28, 1971
REVISED MAY 14, 1975
REVISED JAN., 1983
REVISED OCT., 1995