

# SURVEY & REMONUMENTATION

FEB 11 1998

## SECTION

## LAND CORNER RECORDATION CERTIFICATE Filing Requirement of Act 74, Mich. P.A. 1970

For corners in

WEXFORD  
(County)

Located in:

Corner Code #

1. Public Land Survey T 23N R 12W K-13  
T      R       
T      R       
T      R
2. Property Controlling S      T      R       
in Section S      T      R
3. Miscellaneous S      T      R       
Property in Sec. S      T      R
4. Lot No.         , Recorded Plat
5. Private Claims

RECEIVED

1997 DEC 11 AM 9:28

*Linda Loughmiller*  
WEXFORD COUNTY, MI  
REGISTER OF DEEDS

Register of Deeds Stamp & File Number

I, CRAIG J. PULLEN, in a field survey on JUNE 30, 1997, do hereby state that under requirements of P.A. 74, Michigan P.A. of 1970, the corner points mentioned in lines 1 and 2 above were in conformance with regulations and rules therefore as required in the current manual of survey instructions of the United States Department of the Interior, Bureau of Land Management or by a decree of a Court of Law and/or that the corner points mentioned in lines 3, 4 and 5 above were in conformance with the rules of the Michigan Board of Land Surveyors or by a Decree of a Court of Law; established, re-established, monumented, recovered, found as expressed below:

NOTE: Not more than 2 corners, all in the same town and range, may be recorded on this certificate.

1	A	B	C	D	E	F	G	H	I	J	K	L
2		6		5		4		3		2		1
3												
4		7		8		9		10		11		12
5												
6		18		17		16		15		14		13
7												
8		19		20		21		22		23		24
9												
10		30		29		28		27		26		25
11												
12		31		32		33		34		35		36
13												

A. Description of original monument and accessories and/or subsequent restoration:

- K-13 1837 G.L.O. SURVEY BY J. BRINK, WOOD POST, HEMLOCK 13 N63E 26, SUGAR 12 N70W 33  
1904 A. J. TEED SURVEY IN SECTION 1, T22N, R9W, FOUND STAKE AND REMAINS OF 1 GOV. WITNESS, SUGAR 20 S63½°E 59  
1909 D. E. TEED SURVEY IN SECTION 36, T23N, R12W, CORNER SHOWN ON NOTES, NO WITNESS OR CORNER DESCRIPTION GIVEN  
1986 MITCHELL & ASSOC. SURVEY L. 2, P. 192, & L.C.R.C. L. 3, P. 386, BY R. MITCHELL PS #28417, FOUND A 1½" BY 28" IRON PIPE IN A STONE PILE 16" BELOW THE SURFACE OF A NORTH AND SOUTH TRAIL ROAD AND ON OLD FENCE LINE TO EAST. SET 36" LONG 5" SQUARE CONCRETE MONUMENT WITH BRASS CAP AT FOUND PIPE, N45°E 10" MAPLE 26.25', N36°W 14" ASH 13.42', S48°W 12" MAPLE 17.23', S59°E 16" MAPLE 45.90'

B. Description of corner evidence found and/or method applied in restoring or reestablishing corner:


- K-13 FOUND UNITED STATES FOREST SERVICE CONCRETE MONUMENT WITH BRASS CAP IN CENTERLINE OF NORTH-SOUTH AND 4 PREVIOUS WITNESSES. THIS CORNER IS ACCEPTED AS THE BEST AVAILABLE EVIDENCE OF THE POSITION OF THE CORNER.

C. Description of monument for corner and accessories established to perpetuate locating the position of the corner:

- K-13 SECTION CORNER COMMON TO SECTIONS 35 & 36, T23N, R12W, AND SECTIONS 1 & 2, T22N, R12W  
5" X 36" CONCRETE MONUMENT WITH BRASS CAP STAMPED: RFM, 28417, 1986, 35, 36, 1, 2  
N36°W 18" ASH 13.44'  
N45°E 12" MAPLE 26.25'  
S59°E 16" MAPLE 45.84'  
S48°W 14" MAPLE 17.24'

Peer Group Reviewed and Approved

Date: 30 Oct 97  
*Richard D. Wilcox*  
Richard D. Wilcox, Wexford County Surveyor

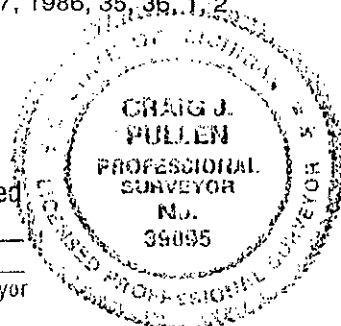

Signed by Craig J. Pullen  
Surveyor's Michigan License No. 39095

Date 2 DEC 97

FORM APPROVED BY MICHIGAN STATE BOARD OF PROFESSIONAL SURVEYORS, JAN. 28, 1978  
REVISED MAY 14, 1978  
REVISED JAN. 1979  
REVISED OCT. 1979