

SURVEY &  
REMONUMENTATION

APR 25 1995

COMMISSION

LAND CORNER RECORDATION CERTIFICATE  
Filing Requirement of Act 74, Mich. P.A. 1970

RECEIVED

1994 DEC -9 PM 2: 58

For corners in  
WEXFORD

(County)

Located In:

Corner Code 77

*Linda Loughmiller*  
WEXFORD COUNTY, MI  
REGISTER OF DEEDS

1. Public Land Survey	T	23N	R	12W	M-7
	T		R		
	T		R		
	T		R		
2. Property Controlling in Section	S		T	R	
	S		T	R	
3. Miscellaneous Property in Sec.	S		T	R	
	S		T	R	

Register of Deeds Stamp & File Number

4. Lot No. \_\_\_\_\_, Recorded Plat \_\_\_\_\_  
5. Private Claims \_\_\_\_\_

	A	B	C	D	E	F	G	H	I	J	K	L	M
2	6		5		4		3		2		1		
3													
4	7		8		9		10		11		12		
5													
6	18		17		16		15		14		13		
7													
8	19		20		21		22		23		24		
9													
10	30		29		28		27		26		25		
11													
12	31		32		33		34		35		36		
13													

CRAIG J. PULLEN

JUNE 1

94

I, \_\_\_\_\_, in a field survey on \_\_\_\_\_, 19\_\_\_\_\_, do hereby certify that under requirements of P.A. 74, Michigan P.A. of 1970, the corner points mentioned in lines 1 and 2 above were in conformance with regulations and rules therefore as required in the current manual of survey instructions of the United States Department of the Interior, Bureau of Land Management or by a decree of a Court of Law and/or that the corner points mentioned in lines 3, 4 and 5 above were in conformance with the rules of the Michigan Board of Land Surveyors or by a Decree of a Court of Law; established, re-established, monumented, re-monumented, recovered, found as expressed below:

**NOTE: Not more than 4 corners, all in the same town and range, may be recorded on this certificate.**

A. Description of original monument and accessories and/or subsequent restoration:

M-7 1838 GLO SURVEY BY J. BRINK, WOOD POST HEM 10 S52W 38 BEECH 8 N52W 13  
1839 GLO SURVEY BY J. BRINK, WOOD POST BEECH 9 S80E 37 BEECH 8 N73E 23  
1899 ALDERMAN SURVEY IN TEED SURVEY BOOK L.1 P.320 NO CORNER DESC. GIVEN IRONWOOD N52E 45½  
1940 SURVEY NOTES BY G. DYKSTERHOUSE FROM R. GRIFFIN L.C.R.C. L.1 P.470 1966, RLS #2752 JUNIOR ENGINEER U.S.F.S. IRON PIPE AT ROAD INTERSECTION WITNESSES - NONE TAKEN.  
1966 U.S.F.S. SURVEY R. GRIFFIN PS #13584 L.C.R.C. L.1 P.470 FOUND ½" IRON PIPE AT ROAD INTERSECTION. REPLACED IRON PIPE WITH 5" X 36" CONC. POST WITH BRASS CAP. DOCK SPIKE IN 7" ASH S73°E 156.75' DOCK SPIKE IN 7" MAPLE S11°E 75.13' 4" X 7' CEDAR POST SOUTH 33' DOCK SPIKE IN 6" MAPLE N50°W 108.25'  
1973 J. ERICKSON PS #16929 L.C.R.C. L.1 P.490 FOUND FOREST SERVICE MON. IN ROAD INTERSECTION. S2°E 95.43' 7" MAPLE S25°E 72.00' 16" MAPLE N55°E 30.08' 10" ASH

B. Description of corner evidence found and/or method applied in restoring or reestablishing corner:

M-7 FOUND U.S.F.S. MONUMENT, ½" PIPE, ALL GRIFFIN'S WITNESSES, AND 2 OF ERICKSON'S WITNESSES INTACT. THIS CORNER IS ACCEPTED AS A CAREFUL AND FAITHFUL PERPETUATION OF THE POSITION OF THE ORIGINAL CORNER, BEING THE SECTION CORNER COMMON TO SECTIONS 13 AND 24, T23N, R12W, AND SECTIONS 18 AND 19, T23N, R11W.


Peer Group Reviewed and Approved

Date: 12-2-94

*Richard D. Wilcox*  
Richard D. Wilcox, Wexford County Surveyor

C. Description of monument for corner and accessories established to perpetuate locating the position of the corner:

M-7 SOUTHEAST CORNER, SECTION 13, T23N, R12W  
UNITED STATES FOREST SERVICE BRASS CAPPED MONUMENT IN ROAD INTERSECTION  
S11°E SPIKE IN 14" MAPLE 75.13'  
SOUTH 4" X 7' CEDAR LOCATION POST 33.00'  
N50°W SPIKE IN 12" MAPLE 108.25'  
S73°E SPIKE IN 14" ASH 156.75'  
S2°E 14" MAPLE 95.43'  
N53°E 16" ASH 30.08'

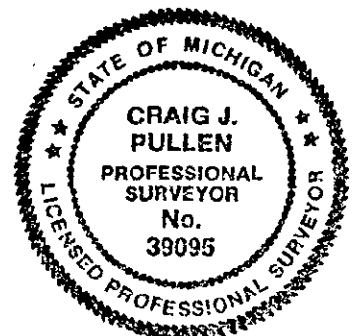

LIBER

04 PAGE 301

Signed by *Craig J. Pullen*  
Surveyor's Michigan License No. 39095

Date NOVEMBER 22, 1994