

SURVEY & REMONUMENTATION

FEB 11 1998

SECTION

For corners in

Wexford

(County)

LAND CORNER RECORDATION CERTIFICATE  
Filing Requirement of Act 74, Mich. P.A. 1970

Located In:

Corner Code #

1. Public Land Survey

T23NR 11W

B-13

2. Property Controlling in Section

3. Miscellaneous Property in Sec.

S  
S  
S  
S

T  
T  
R  
R  
4. Lot No. \_\_\_\_\_, Recorded Plat \_\_\_\_\_

5. Private Claims \_\_\_\_\_

RECEIVED

1997 DEC 11 AM 9:31

Linda Laughmiller  
WEXFORD COUNTY, MI  
REGISTER OF DEEDS

Register of Deeds Stamp & File Number

I, George Smith

, in a field survey on 9-25, 19 97 do hereby state that under requirements of P.A. 74, Michigan P.A. of 1970, the corner points mentioned in lines 1 and 2 above were in conformance with regulations and rules therefore as required in the current manual of survey instructions of the United States Department of the Interior, Bureau of Land Management or by a decree of a Court of Law and for that the corner points mentioned in lines 3, 4 and 5 above were in conformance with the rules of the Michigan Board of Land Surveyors or by a Decree of a Court of Law; established, re-established, monumented, recovered, found as expressed below:

NOTE: Not more than 2 corners, all in the same town and range, may be recorded on this certificate.

A. Description of original monument and accessories and/or subsequent restoration:

B-13) 1837 GLO Quarter Section Post by John Brink, Deputy Surveyor; Beech 13, N37°E 33, Sugar 10, N32°W 35'

B. Description of corner evidence found and/or method applied in restoring or reestablishing corner:

Re-established corner by single proportionate measure between found southwest corners of Section 31 and found Southeast corner of Section 31. Corner falls  $\pm 24'$  Westerly of old fence. This corner is accepted as a careful and faithful re-establishment of the position of the original corner being the quarter corner common to Section 31, T23N-R11W and Section 6, T22N-R11W.

C. Description of monument for corner and accessories established to perpetuate locating the position of the corner:

Set 5/8" x 36" iron with Wexford County brass cap, stamped: S 1/4 33, 1997, 39098

N45°E 5.25' 8" Cherry  
S57°E 6.62' 4" Beech  
S37°E 27.61' 14" Beech  
S75°E 31.48' 8" Maple


Peer Group Reviewed and Approved

Date: 30 Oct 97

Richard D. Wilcox  
Richard D. Wilcox, Wexford County Surveyor

Signed by

Surveyor's Michigan License No.

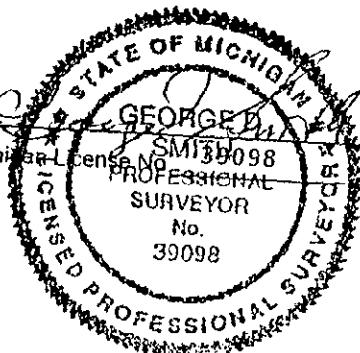

Date 10-30-97