


LAND CORNER RECORDATION CERTIFICATE
Filing Requirement of Act 74, Mich. PA 1970

Wexford (County) Located In Corner Code #
1. Public Land Survey T 24N R 11W I-2
2. Property Controlling in Section S T R
3. Miscellaneous Property in Section S T R
4. Lot No: Recorded Plat:
5. Private Claims:

Register of Deeds Stamp & File Number

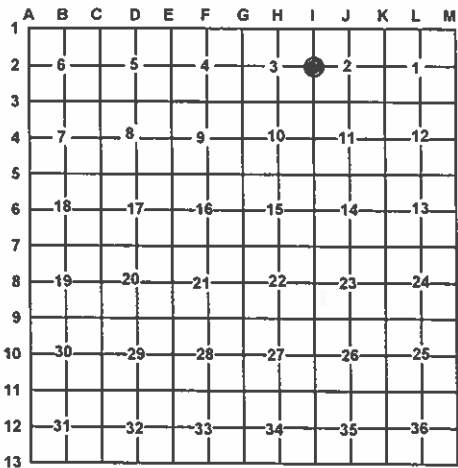

I, Craig W. McVean, in a field survey on May 24, 2011 do hereby state that under requirements of PA 74, Michigan PA of 1970, the corner points mentioned in lines 1 and 2 above were in conformance with regulations and rules therefore as required in the current manual of survey instructions of the United States Department of the Interior, Bureau of Land Management or by a decree of a Court of Law and/or that the corner points mentioned in lines 3, 4 and 5 above were in conformance with the rules of the Michigan Board of Land Surveyors or by a Decree of a Court of Law, established, re-established, monumented, recovered, found as expressed below:

NOTE: Not more than 2 corners, all in the same town and range, may be recorded on this certificate.

A. Description of original monument and accessories and/or subsequent restoration:

- I-2 - 1839 - GLO - J. Brink - Set 1/4 Post
1) Sugar 10" N15°W 40 L.
2) Maple 12" S60 1/2°E 29 L.
- 1942 - M. Schaaf - S. from random 45.41 - Intersect what may be 1/4 Cor. 2 links west of post. SE stp. with some cuttings and NW site of tip up.
3) Wh. Pine Stp. 48" S37°W 78; 4) Wh. Pine Stp. 40" S50°E 151;
5) Wh. Pine Stp. 28" N74°E 171

B. Description of corner evidence found and/or method applied in restoring or re-establishing corner:

I-2 - 1/4 Corner common to Section 2 & 3, T24N, R11W - Fd. remains of 3 Marcus Schaaf BT's. Dug at witness cross and found 4" diameter stake shadow in white sand with nice point. No GLO evidence found. This area is now a Red Pine Plantation. This position fits record GLO Bearing and distance south from 'I-1' closely. Measured grid bearing and distance of N1°19'19"E 2994.37' (North 2996.4' - GLO, 2995.74' - MS) to 'I-1' and S4°20'21"W 2627.48' (2640' - GLO) to 'I-3'. A single proportional position for 'I-2' would be N82°44'50"W 73.98' from the MS position. The GLO notes along this north-south line omit a major swamp that is south of 'I-2'; thus it is questionable whether the south 1/2 mile was ever run. Though Schaaf didn't conclusively feel he had the original corner it is very possible this is the original corner position. MS stake shadow accepted as the best available evidence of the position of the original corner.

C. Description of monument for corner and accessories established to perpetuate locating the position of the corner:

- I-2 - Set stamped 4" DNR Alum. Cap on 1" x 36" long galv. iron pipe at found stake shadow.
Set Blue Carsonite Post 1' North
N70°E 25.51' to set Nail & Tag (N & T) in N. side 13" Red Pine scribed 'XBT'
S18°E 25.70' to set N & T in E. side 12" Red Pine scribed 'XBT'
S24°W 23.74' to set N & T in SE side 8" Red Pine scribed 'XBT'
N51°W 4.13' to set N & T in SW side 10" Red Pine scribed 'XBT'



Signed by: [Signature]
Surveyor's Michigan License No.: 39088

Date: 12/16/2011