

LAND CORNER RECORDATION CERTIFICATE
Filing Requirement of Act 74, Mich, P.A. 1970

SURVEY &
REMONUMENTATION

For corner in

Washtenaw
(County)

Located in:

Corner Code #

NOV 02 1999

SECTION

1. Public Land Survey

T 1S R 3E

K-8

2. Property Controlling
in Section

S T R
S T R

3. Miscellaneous
Property in Sec

S T R
S T R



5017323

Page: 1 of 2

02/25/1999 02:59P

L-2 P-210

Peggy M. Haines - Washtenaw Co. CORREM

Register of Deeds Stamp & File Number

4. Lot No. _____, Recorded Plat _____

5. Private Claims _____

I, Charles C. Wilson, in a field survey on June, 19 98,

do hereby certify that under requirements of P.A. 74, Michigan P.A. of 1970, the corner points mentioned in lines 1 and 2 above were in conformance with regulations and rules therefore as required in the current manual of survey instruction of the United States Department of the interior, Bureau of Land Management or by a decree of a Court of Law and/or that the corner points mentioned in lines 3, 4 and 5 above were in conformance with the rules of the Michigan Board of Land Surveyors or by a Decree of a Court of Law; established, re-established, monumented, re-monumented, recovered, found as expressed below.

NOTE: Not more than 4 corners, all in the same town and range, may be recorded on this certificate.

A. Description of original monument and accessories and/or subsequent restoration:

United States Government Survey, 1815 Instructions, Surveyed 1825

Bearing Trees A) W. Oak 16" S30-1/2deg.W 19.14

B) W. Oak 12" N28deg.E 13.20

Continued on Back

B. Description of corner evidence found and/or method applied in restoring or reestablishing corner:

Found 1" x 20" Iron Pipe 3" above ground surface and surrounded with stones. Removed but found no evidence of another point. Replaced 1" Iron Pipe with Remonumentation Cap Stamped #13604 to ground surface.

C. Description of monument for corner and accessories established to perpetuate locating the position of the corner:

1" Iron Pipe with Remonumentation Cap Stamped #13604 (to ground surface)

1) Remains of Large Stump NE'ly 1'-

2) 10" Oak N'ly 17.54 (Nail & RT W/S)


3) 14" Oak N20deg.W 20.95 (Nail & RT E/S)

4) 28" Oak W'ly 27.76 (Nail & RT N/S)

5) 10" Hickory N65deg.E 20.45 (Nail & RT SE/S)

I believe this point should be accepted as the best available evidence of the position of the original corner.

This corner was ratified by the Peer Committee on August 10, 1998

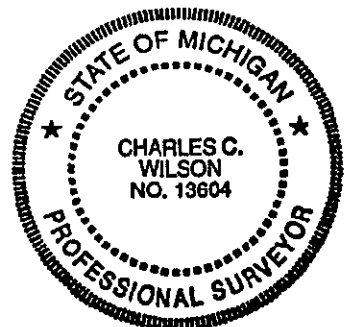

Signed by

Surveyors Michigan's License No.

13604

Date

August 10, 1998

APPROVED

DATE 8-10-98

CO. REP. KA

COPY

K-8

Paragraph A continued:

Washtenaw County Road Commission Grid Book & Consumer Power Co. Drawing
E.J. McCombs, PLS#10696, November 1965

Found 1" Iron Pipe

- | | | |
|--------------------------|--------------------------|------------------------------|
| 1) 40" Oak NE'ly 1.0 | 2) 8" W. Oak North 17.75 | 3) 10" W. Oak N20deg.W 21.00 |
| 4) 21" B. Oak West 28.20 | | |

C. Wilson & Associates, Inc., Charles C. Wilson, PLS#13604, May 1978

Survey Drawing

- | | | |
|----------------------------|--------------------------|------------------------------|
| 1) 40" Oak Stump NE'ly 1.0 | 2) 8" W. Oak North 17.75 | 3) 10" W. Oak N20deg.W 21.00 |
| 4) 21" B. Oak West 28.20 | | |

Charles C. Wilson, PLS#13604, October 1978

Land Corner Recordation Certificate, Liber 5, Page 104, Found 1" Iron Pipe

- | | | |
|----------------------------|--------------------------|------------------------------|
| 1) 40" Oak Stump NE'ly 1.0 | 2) 8" W. Oak North 17.75 | 3) 10" W. Oak N20deg.W 21.00 |
| 4) 21" B. Oak West 28.20 | | |

Washtenaw Eng. Co., Inc., Norman N. Fahrner, PLS#17620, May 1980

Survey Drawing, Found 1" Iron Pipe

- | | |
|--------------------------------|----------------------------------|
| 1) 40" Stump NE'ly 1.0 to face | 2) 10" W. Oak North 17.33 (nail) |
| 4) 21" B. Oak West 27.7 (nail) | |

SURVEY &
REMONUMENTATION

NOV 02 1999

SECTION

Atwell-Hicks, Inc., John L. Snyder, PLS#13352, February 1982

Survey Drawing, Found 1" Iron Pipe

- | | | |
|----------------------------|--------------------------|------------------------------|
| 1) 40" Oak Stump NE'ly 1.0 | 2) 8" W. Oak North 17.75 | 3) 10" W. Oak N20deg.W 21.00 |
| 4) 21" B. Oak West 28.20 | | |

Washtenaw Eng. Co., Inc., Norman N. Fahrner, PLS#17620, December 1983

Survey Drawing, Found 1" Iron Pipe

- | | | |
|--------------------------------|----------------------------------|-------------------------------------|
| 1) 40" Stump NE'ly 1.0 to face | 2) 10" W. Oak North 17.33 (nail) | 3) 10" W. Oak N20deg.W 20.70 (nail) |
| 4) 21" B. Oak West 27.7 (nail) | | |

Washtenaw Eng. Co., Inc., Norman N. Fahrner, PLS#17620, April 1985

Survey Drawing, Found 1" Iron Pipe

- | | | |
|--------------------------------|----------------------------------|-------------------------------------|
| 1) 40" Stump NE'ly 1.0 to face | 2) 10" W. Oak North 17.33 (nail) | 3) 10" W. Oak N20deg.W 20.70 (nail) |
| 4) 21" B. Oak West 27.7 (nail) | | |

Washtenaw Eng. Co., Inc., Norman N. Fahrner, PLS#17620, August 1997

Survey Drawing, Found 1" Iron Pipe

- | | | |
|--------------------------------------|-------------------------------------|---------------------------------|
| 2) 10" W. Oak North 17.33 (nail) | 3) 10" W. Oak N20deg.W 20.70 (nail) | 4) 21" B. Oak West 27.60 (nail) |
| 5) 10" Hickory N65deg.E 20.41 (nail) | | |



- COPY -