

SURVEY &
REMONUMENTATION

LAND CORNER RECORDATION CERTIFICATE

NOV 02 1999

Filing Requirement of Act 74, Mich, P.A. 1970

SECTION

For corner in

Washtenaw
(County)

Located in:

Corner Code #

1. Public Land Survey

T 1S R 3E

M-6

T R

T R

T R

T R

2. Property Controlling
in Section

S T R

S T R

3. Miscellaneous
Property in Sec

S T R

S T R

4. Lot No. , Recorded Plat

5. Private Claims

Peggy M. Haines - Washtenaw Co. CORREM

5017327

Page: 1 of 2

02/25/1999 02:59P

L-2 P-218

Register of Deeds Stamp & File Number

I, Charles C. Wilson, in a field survey on June, 19 98,

do hereby certify that under requirements of P.A. 74, Michigan P.A. of 1970, the corner points mentioned in lines 1 and 2 above were in conformance with regulations and rules therefore as required in the current manual of survey instruction of the United States Department of the interior, Bureau of Land Management or by a decree of a Court of Law and/or that the corner points mentioned in lines 3, 4 and 5 above were in conformance with the rules of the Michigan Board of Land Surveyors or by a Decree of a Court of Law; established, re-established, monumented, re-monumented, recovered, found as expressed below.

NOTE: Not more than 4 corners, all in the same town and range, may be recorded on this certificate.

A. Description of original monument and accessories and/or subsequent restoration:

United States Government Survey, 1815 Instructions, Surveyed 1824

Bearing Trees A) W. Oak 17" S8deg.E 33.00

B) B. Oak 23" N13deg.W 42.24

Continued on Back

B. Description of corner evidence found and/or method applied in restoring or reestablishing corner:

Found 1/2" x 30" Iron Pipe. Removed and found no evidence of another corner. Replaced 1/2" x 30" Iron Pipe and drove a 3/4" x 18" Iron Pipe over the 1/2" Iron Pipe. Placed Remonumentation Cap stamped #13604 at ground surface.

C. Description of monument for corner and accessories established to perpetuate locating the position of the corner:

3/4" x 18" Iron Pipe with a Remonumentation Cap Stamped #13604 (at ground surface)

1) 28" Walnut N60deg.E 13.00 (Nail & RT S/S)

5) 8" Hickory (Dead) S'y 18.18 (Nail & RT W/S)

7) 14" Oak S80deg.W 22.00 (Nail & RT N/S)

8" Oak S35deg.W 8.37 (Nail & RT NW/S)

Most E'y Corner of Building nearest Lake N'y 44.50

Fence N'y 2'+-

I feel that this point should be accepted as the best available evidence of the position of the original corner.

This corner was ratified by the Peer Committee on August 10, 1998

Signed by

Surveyors Michigan's License No.

13604

Date


August 10, 1998

APPROVED

DATE 8-10-98

CO. REP. KA

COPY

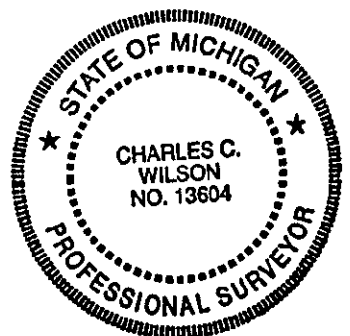

SECTION

M-6

Paragraph A Continued:



5017327

Page: 2 of 2

02/25/1999 02:59P

Peggy M. Haines - Washtenaw Co. CORREM L-2 P-219

Yocum, 1850+-

Washtenaw County Road Commission Grid Book & Washtenaw County Road Commission Book 134, Page 30

A) W. Oak 17" S8deg.E 33.00

B. Oak 23" N13deg.W 42.24

W.J. Armstrong, PLS#2444, May 1940

Washtenaw County Road Commission Grid Book

Found Wooden Stake

1) 26" Walnut NE'y 13.05

2) 5" W. Oak E'y 24.5

3) 6" B. Oak SE'y 13.0

4) 6" Walnut WSdegW 6.9

Atwell-Hicks Book 575, Page 75, May 1951

1) 26" Walnut NE'y 13.05

2) 5" W. Oak E'y 24.5

3) 6" B. Oak SE'y 13.0

4) 6" Walnut WSdegW 6.9

North Lake Shores Subdivision, November 1951

Liber 11, Page 27

Herbert S. Hicks, PLS#1715

Point of Beginning

Atwell-Hicks Grid Book

1) 28" Walnut NE'y 13.00 (spike)

2) 6" W. Oak E'y 24.5

3) 8" B. Oak SE'y 12.98 (spike)

5) 6" Hickory S'y 17.85

6) 16" Oak SW'y 18.15

C. Wilson & Associates, Inc., Charles C. Wilson, PLS#13604, February 1978

Survey Drawing

3) 8" Oak S10deg.E 12.90 (nail)

6) 18" Oak SW'y 18.12 (nail)

7) 12" Oak S80deg.W 21.75 (nail)

8) 30" Oak E'y 13.0 (nail)

Charles C. Wilson, PLS#13604

Land Corner Recordation Certificate, Liber 5, Page 159

Found 1/2" Iron Pipe

3) 8" Oak S10deg.E 12.90 (nail)

6) 18" Oak SW'y 18.12 (nail)

7) 12" Oak S80deg.W 21.75 (nail)

8) 30" Oak E'y 13.0 (nail)