

SURVEY & REMONUMENTATION

MAY - 1 1995

COMMISSION

LAND CORNER RECORDATION CERTIFICATE  
Filing Requirement of Act 74, Mich. P.A. 1970

For corners in

WASHTENAW  
(County)

Located In:

Corner Code ~~##~~

1. Public Land Survey T 1 S R 5 E 1 - 9  
T \_\_\_\_\_ R \_\_\_\_\_  
T \_\_\_\_\_ R \_\_\_\_\_  
T \_\_\_\_\_ R \_\_\_\_\_  
2. Property Controlling S \_\_\_\_\_ T \_\_\_\_\_ R \_\_\_\_\_  
in Section S \_\_\_\_\_ T \_\_\_\_\_ R \_\_\_\_\_  
3. Miscellaneous S \_\_\_\_\_ T \_\_\_\_\_ R \_\_\_\_\_  
Property in Sec. S \_\_\_\_\_ T \_\_\_\_\_ R \_\_\_\_\_

4. Lot No. \_\_\_\_\_, Recorded Plat \_\_\_\_\_  
5. Private Claims \_\_\_\_\_

I, I. JOHN JEKABSON, in a field survey on 20 DECEMBER, 19 93, do hereby certify that under requirements of P.A. 74, Michigan P.A. of 1970, the corner points mentioned in lines 1 and 2 above were in conformance with regulations and rules therefore as required in the current manual of survey instructions of the United States Department of the Interior, Bureau of Land Management or by a decree of a Court of Law and/or that the corner points mentioned in lines 3, 4 and 5 above were in conformance with the rules of the Michigan Board of Land Surveyors or by a Decree of a Court of Law; established, re-established, monumented, re-monumented, recovered, found as expressed below:

NOTE: Not more than 4 corners, all in the same town and range, may be recorded on this certificate.

A. Description of original monument and accessories and/or subsequent restoration:

1819 G.L.O. Set post Witnesses: W.O. 14 S.2W. 32  
WAMPLER R.O. N.30E. 13

1932 25 June

WASHTENAW CO. RD. COMM. - W.J. ARMSTRONG P.S. # 2444

Found a large stone. Reset with a 1½"x42" iron pipe with 4 bricks around it.

Witnesses: W. Oak, 36" N. 64° W. 63.6 1  
W. Oak, 27" S. 53° E. 45.5 2  
Y. Oak, 7" S. 43° W. 42.85 3  
B. Oak, 26" N. 25° W. 69.0 4  
3 R. of W. Pipes ( Hand written ) R/W Pipe S. 88° E. 33.50  
R/W Pipe S. 47° W. 46.38  
R/W Pipe N. 42° W. 46.57

SEE BACK OF THIS SHEET (NEXT PAGE)  
FOR CONTINUATION OF SECTION "A"

B. Description of corner evidence found and/or method applied in restoring or reestablishing corner:

FOUND ½" IRON PIPE 1" BELOW ASPHALT  
SURFACE OF WEBSTER-CHURCH ROAD

USING 8 WITNESSES FROM SECTION "A"

C. Description of monument for corner and accessories established to perpetuate locating the position of the corner:

Found ½" Iron Pipe 1" below Asphalt surface of Webster-Church Road  
Two 1" Iron Pipes (A-H & NNF) East 33.05  
Tri 20" Red Maple (PK & Tag N sd.) S 85° E 58.40 10  
C/L 36" Oak Stump S 53° E 45.5 2  
C/L 48" Oak (Rotten Center) S 30° E 78.8 9  
24" White Oak (PK & Tag E sd.) S 25° W 88.90 6  
13" Hickory (PK & Tag SE sd.) S 35° W 64.20 5  
1" Iron Pipe at Steel Fence Post S 45° W 46.48 7  
10" Hickory (PK & Tag S sd.) S 75° W 54.68 12  
12" Elm (Nail SW sd.) N 45° W 63.37 11  
½" ReBar (Progressive) N 45° W 46.19

I conclude that after careful study of the record documentation and field observations, that this corner is a careful and faithful perpetuation of the position of the original corner.

Signed by I. John Jekabson Date 12 October, 1994

Surveyor's Michigan License No. 19836

RECORDED  
WASHTENAW COUNTY, MI  
Dec 1 11 31 AM '94  
PEGGY M. HAINES  
COUNTY CLERK/REGISTER

LIBER


Register of Deeds Stamp & File Number

	A	B	C	D	E	F	G	H	I	J	K	L	M
2	6	5	4	3	2								
3													
4	7	8	9	10	11	12							
5													
6	18	17	16	15	14	13							
7													
8	19	20	21	22	23	24							
9													
10	30	29	28	27	26	25							
11													
12	31	32	33	34	35	36							
13													

APPROVED

DATE 1/25/94

CO. REP. Kx

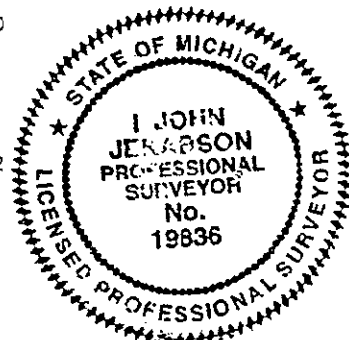

## 1993 WASHTENAW COUNTY REMONUMENTATION PROGRAM

## WEBSTER TOWNSHIP TOWN 1 SOUTH, RANGE 5 EAST

## I-9 (SECTION CORNER COMMON TO SECTIONS 22, 23, 26, &amp; 27)

## HISTORY: CONTINUATION OF SECTION "A"

1971 6 August	WASHTENAW ENGINEERING CO., INC. - NORMAN F. FAHRNER #17620 Survey in S.W. 1/4 of Section 23 Job # 7163 Found Iron Pipe in pavement	Witnesses:	33" W. Oak 15" Y. Oak 10" Hickory 18" Oak	S 53° E 45.5 S 43° W 42.85 S 35° W 64.2 S 30° W 88.9	2 3 5 6
1971 25 August	WASHTENAW ENGINEERING CO., INC. - NORMAN F. FAHRNER #17620 P.A. 74, Michigan P.A. of 1970 Liber 1 Page 211 Found Iron Pipe in pavement. Same witnesses as 1971 6 August				
1971 22 October	ATWELL-HICKS, INC. - JOHN L. SNYDER #13352 Survey in S.E. 1/4 of Section 22 Job # 27297 Found Iron Pipe	Witnesses:	36" W. Oak 24" Oak Fence Post 12" Hickory Hickory	S 53° E 45.5 S 43° W 42.8 S 45° W 46.5 S 30° W 64.3 N 25° W 87.3	2 3 7 5 8
1972 12 May	ATWELL-HICKS, INC. - JOHN L. SNYDER #13352 Survey in S.E. 1/4 of Section 22 Job # 27620 Found Iron Pipe				
1972 26 May	ATWELL-HICKS, INC. - JOHN L. SNYDER #13352 Survey in S.E. 1/4 of Section 22 Job # 27620 Found Iron Pipe				
1972 6 June	ATWELL-HICKS, INC. - JOHN L. SNYDER #13352 Survey in S.E. 1/4 of Section 22 Job # 27620 Found Iron Pipe				
1973 17 January	WASHTENAW ENGINEERING CO., INC. - NORMAN F. FAHRNER #17620 Survey in S.W. 1/4 of Section 23 Job # 9506 Found Iron Pipe in Pavement				
1974 3 April	ATWELL-HICKS, INC. - JOHN L. SNYDER #13352 Survey in N.E. 1/4 of Section 27 Job # 28830 Found Iron Pipe	Witnesses:	38" W. Oak (nail in s'ly side) 32" R. Oak 14" Y. Oak (nail in s'ly side) 16" Shag Hickory 20" Forked Maple 10" Shag Hickory	S 49° E 45.43 S 30° E 78.8 S 45° W 42.86 N 25° W 87.3 E'ly 58.4 S 28° W 64.3	2 9 3 8 10 5
1975 12 July	ATWELL-HICKS, INC. - JOHN L. SNYDER #13352 Survey in S.E. 1/4 of Section 22 Job # 29408 Found Iron Pipe				
1979 8 May	ATWELL-HICKS, INC. - PAUL V. SCHWIMMER # 24618 Survey in N.E. 1/4 of Section 27 Job # 33005 Found 1/2" Iron Pipe	Witnesses:	R. Oak 32" Oak 14" Forked Maple 20" Hickory 10"	S 30° E 78.8 S 45° W 42.9 E'ly 58.4 S 28° W 64.3	9 3 10 5
1979 15 May	ATWELL-HICKS, INC. - JOHN L. SNYDER #13352 P.A. 74, Michigan P.A. of 1970 Liber 5 Page 189 Found 1/2" Iron Pipe				
1979 16 May	WASHTENAW ENGINEERING CO., INC. - NORMAN F. FAHRNER #17620 Survey in S.W. 1/4 of Section 23 Job # 16824 Found Iron Pipe in Pavement				
1981 18 March	WASHTENAW ENGINEERING CO., INC. - NORMAN F. FAHRNER #17620 Survey in S.W. 1/4 of Section 23 Job # 16824 Found Iron Pipe in Pavement				
1981 4 September	ATWELL-HICKS, INC. - ROBERT G. MACOMBER # 27453 Survey in the N.W. 1/4 Section 26 Job # 34284 Found 1/2" Iron Pipe w/nail				
1987 22 May	ATWELL-HICKS, INC. - ROBERT G. MACOMBER # 27453 Survey in the S.E. 1/4 Section 22 Job # 37162 Found 1/2" Iron Pipe	Witnesses:	Stump 20" Forked Maple 36" Red Oak Stump Fence Post	S 49° E 45.5 E'ly 58.3 S 30° E 78.8 S 45° W 42.9 S 45° W 46.5	2 10 9 3 7
1989 March	LAND SURVEYING CONSULTANTS - R. TIMOTHY TIETSEMA # 20712 Survey in S.W. 1/4 Section 23 Job # 00989-1S5E23 Found 1" Iron Pipe	Witnesses:	Fence Post 16" Hickory 32" Oak 38" Oak 36" Maple	S 45° W 46.45 S 28° W 84.30 S 30° E 78.80 S 49° E 45.43 East 58.40	7 5 9 2 10
1989 12 December	WASHTENAW ENGINEERING CO., INC. - Survey in S.W. 1/4 of Section 23 Job # 22719 Found Iron Pipe in Pavement				
1991 3 June	ATWELL-HICKS, INC. Survey in S.W. 1/4 of Section 23 Found Iron Pipe				
1991 August	LAND SURVEYING CONSULTANTS - R. TIMOTHY TIETSEMA # 20712 Survey in S.E. 1/4 of Section 23 Job # 07091 - 1S5E22 Found 1" Iron pipe	Witnesses:	38" Maple 41" Hickory (?) 16" Hickory	S 89 E 58.17 S 20 E 77.69 S 31 W 64.15	10 9? 5
1992 30 March	WASHTENAW ENGINEERING CO., INC. - NORMAN F. FAHRNER #17620 Survey in S.W. 1/4 of Section 23 Job # 23833 Found Iron Pipe in Pavement				
1992 1 July	PROGRESSIVE - RICHARD F. FRANK # 14093 Survey in SE 1/4 of Section 22 Job # 9206-26 Found 3/4" Rod	Witnesses:	N 45° W 63.37 to spike in S. side of 12" Elm S 20° E 77.64 to spike in W. side of 50" Oak S 40° W 64.19 to spike in E. side of 15" Hickory S 75° W 54.85 to spike in S. side of 15" Hickory		11 9 5 12