

SURVEY &
REMONUMENTATION

Liber 000001 Page 0473 RM

MAY 09 1996

COMMISSION LAND CORNER RECORDATION CERTIFICATE
Filing Requirement of Act 74, Mich. P.A. 1970

For corners in

Washtenaw
(County)

Located In:

Corner Code ##

- | | | |
|-------------------------|-------------------------|------------|
| 1. Public Land Survey | T <u>3S</u> R <u>6E</u> | <u>K-9</u> |
| | T _____ R _____ | _____ |
| | T _____ R _____ | _____ |
| | T _____ R _____ | _____ |
| 2. Property Controlling | S _____ T _____ R _____ | _____ |
| in Section | S _____ T _____ R _____ | _____ |
| 3. Miscellaneous | S _____ T _____ R _____ | _____ |
| Property in Sec. | S _____ T _____ R _____ | _____ |

4. Lot No. _____, Recorded Plat _____
5. Private Claims _____

I, Kenneth R. Coleman in a field survey on January 19, 19 95
do hereby certify that under requirements of P.A. 74, Michigan P.A. of 1970, the corner points mentioned
in lines 1 and 2 above were in conformance with regulations and rules therefore as required in the
current manual of survey instructions of the United States Department of the Interior, Bureau of Land
Management or by a decree of a Court of Law and/or that the corner points mentioned in lines 3, 4 and 5
above were in conformance with the rules of the Michigan Board of Land Surveyors or by a Decree of a
Court of Law; established, re-established, monumented, re-monumented, recovered, found as
expressed below:

NOTE: Not more than 4 corners, all in the same town and range, may be recorded
on this certificate.

A. Description of original monument and accessories and/or subsequent restoration:

1815	GLO	GLO notes
Set post.		
26" W. Oak	S71° W	65.34
14" Do.	S21° E	66.66

"A" continued on back

B. Description of corner evidence found and/or method applied in restoring or reestablishing corner:

1-27-1995 Atwell-Hicks, Inc. Remonumentation
Found 3/4" I.P. at road surface. Removed I.P. Found nothing metallic below.


C. Description of monument for corner and accessories established to perpetuate locating the position of the corner:

I find this corner to be the best available evidence of the position of the original
corner.

"C" continued on back

Signed by Kenneth R. Coleman

Surveyor's Michigan License No. 37271

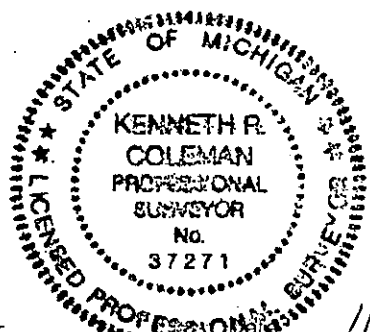

- COPY -
RECORDED
WASHTENAW COUNTY, MI
MAR 29 1 39 PM '96
REGISTER OF DEEDS STAMP & FILE NUMBER

	A	B	C	D	E	F	G	H	I	J	K	L	M
2	6		5		4		3		2		1		
3													
4	7		8		9		10		11		12		
5													
6	18		17		16		15		14		13		
7													
8	19		20		21		22		23		24		
9													
10	30		29		28		27		26		25		
11													
12	31		32		33		34		35		36		
13													

APR 23 1996

11-21-1995

-Copy-

"A" continued...

11-1887 C.S. Woodard

Woodard's notes

Left corner as found - stake and stones.

- | | | |
|---------------|-------|-------|
| 2) 18" B. Oak | S21°W | 88.1 |
| 3) 14" W. Oak | S13°E | 124.7 |

9-3-30 Atwell-Hicks, Inc.

Field Book 527-74

Using county highway witnesses dug and found a 2½" round stake 2' long now, originally longer, 2" X 2" hub was above this, stones around. Set 1" iron pipe then ½" iron pipe above, many stones about. South side of Ford-Textile Road.

- | | | |
|-------------------------|--------|-------|
| 2) 30" B. Oak | S22°W | 89.5 |
| 4) 8" Cherry | S84½°W | 37.1 |
| 5) 10" W. Oak | S29°W | 54.75 |
| 6) 10" Cherry | S22°E | 86.9 |
| 7) 12" Cherry | S89°E | 75.6 |
| 8) Range of fence west | SOUTH | 3' |
| 9) CL proposed pavement | 3.7 | WEST |

No date Atwell-Hicks, Inc.

Compiled data 235-11

- | | | |
|---------------------|-------|------|
| 4) 8" Choke Cherry | W'ly | 36.4 |
| 6) 10" Choke Cherry | S20°E | 86.1 |
| 7) 12" Choke Cherry | E'ly | 75.0 |
| 10) 7" Choke Cherry | SE'ly | 32.2 |

8-6-73 Midwestern Consulting, Inc. Survey

Found iron in mon. box 3.7' east of centerline Carpenter.

- | | | | |
|-------------------------|-------|-------|---------------|
| 9) Centerline Carpenter | WEST | 3.7 | |
| 11) M.B.T. pole | S85°E | 55.53 | Spike W. side |
| 12) P.P. | N45°E | 85.57 | Spike W. side |
| 13) P.P. | N40°W | 85.91 | Spike E. side |

9-26-83 Robert A. Campbell

L.C.R.C. L.6, P.319

Found ½" I.P. in mon. box. Reset w/3/4" X 18" I.P. at road surface.

- | | | | |
|-----------------------|-------|-------|------------------------|
| 9) CL road | WEST | 3.3 | |
| 12) P.P. | N34°E | 85.51 | Nail & flasher W. side |
| 13) P.P. | N30°W | 86.26 | Nail N.E. side |
| 14) Vertical gas vent | S42°E | 66.2 | |
| 15) CL Textile Road | NORTH | 35' | |

3-15-85 Midwestern Consulting, Inc. Survey

Found I.P.

- | | | |
|-----------------------|-------|------|
| 14) Vertical gas vent | S42°E | 66.2 |
| 15) CL Textile Road | NORTH | 35.0 |

9-6-90 Roskelly, Jekabson & Assoc. Survey

- | | | | |
|----------------------|-------|-------|------|
| 12) P.P. | N35°E | 85.51 | Nail |
| 13) P.P. | N30°W | 86.26 | Nail |
| 14) Center gas vent | S45°E | 66.20 | |
| 15) CL pave.-Textile | NORTH | 35.00 | |

"C" continued...

11-9-1995 Atwell-Hicks, Inc.

Remonumentation

Set 1" X 24" I.P. with remon. cap in mon. box.

- | | | |
|------------------------|-------|--------------------|
| 8) Range of fence west | SOUTH | 4.6 |
| 9) C.L. pavement | WEST | 3.4 |
| 12) P. pole | N30°E | 85.30 to nail & RT |
| 13) P. pole | N34°W | 86.60 to nail & RT |
| 14) Gas vent | S47°E | 66.35 |
| 15) PK C.L. Textile | N4°W | 37.00 |
| 16) NW corner garage | S39°E | 138.00 |
| 17) P. pole | S87°E | 37.84 to nail & RT |
| 18) 12" Elm | S40°W | 60.14 to nail & RT |

APPROVED

DATE 4/24/95

CO. REP. K₂