

MAY 10 2000

SECTION

LAND CORNER RECORDATION CERTIFICATE  
Filing Requirement of Act 74, Mich. P.A. 1970

For corners in

WASHTENAW  
( County )

Located In: Corner Code #

1. Public Land Survey T 4S R 7E F-11  
AUGUSTA TWP T R  
T R  
T R  
T R

2. Property controlling S T R  
in Section S T R


3. Miscellaneous S T R  
Property in Sec. S T R

4. Lot No. , Recorded Plat

5. Private Claims

5094704  
Page: 1 of 2  
02/07/2000 02:55P  
L-2 P-282  
Peggy M. Haines - Washtenaw Co. CORREM  
- Copy - Register of Deeds Stamp & File Number

I, LORI E. BEYER, in a field survey on OCTOBER 03, 19 99, do hereby certify that under requirements of P.A. 74, Michigan P.A. of 1970, the corner points mentioned in lines 1 and 2 above were in conformance with regulations and rules therefore as required in the current manual of survey instructions of the United States Department of the Interior, Bureau of Land Management or by decree of a Court of Law and/or that the corner points mentioned in lines 3, 4 and 5 above were in conformance with the rules of the Michigan Board of Land Surveyors or by Decree of a Court of Law; established, re-established, monumented, re-monumented, recovered, found as expressed below:

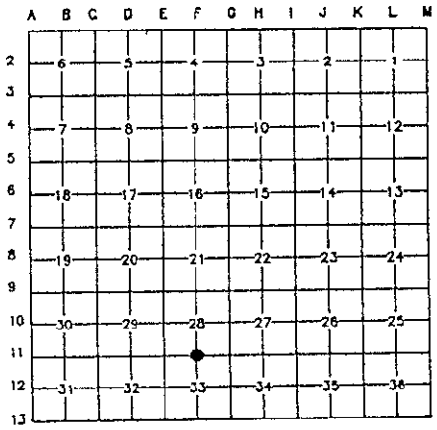

1999 REMONUMENTATION CORNER


A. Description of original monument and accessories and/or subsequent restoration:  
G.L.O. - JOSEPH FRANCIS - 1819  
SET POST  
12" ASH N 15° E 17 LINKS  
9" ASH S 11° W 6 LINKS

Continued on Back

B. Description of corner evidence and/or method applied in restoring or reestablishing corner:  
FOUND 1" IRON BAR 3" BELOW GRAVEL. DUG 16" AND FOUND NOTHING ELSE.  
CHECKED WITNESSES, SET ALUMINUM REMON. CAP STAMPED WITH #41092 OVER IRON BAR.  
BRIDGE MENTIONED IN EARLY WITNESSES HAS BEEN REPLACED WITH NEW TIMBER BRIDGE.

C. Description of monument for corner and accessories established to perpetuate locating the position of the corner:  
1" IRON BAR WITH ALUMINUM REMON. CAP STAMPED #41092 IN MONUMENT BOX AT CENTERLINE  
INTERSECTION OF ARKONA AND FULLER ROADS.

4) UTILITY POLE	N 43° W	45.01'	SET NAIL/TAG NORTHEAST SIDE
6) UTILITY POLE	S 23° E	43.99'	SET NAIL/TAG EAST SIDE
7) UTILITY POLE	N 33° E	46.40'	SET NAIL/TAG EAST SIDE
9) NE COR BRIDGE	S 05° E	91.75'	SET NAIL/TAG TOP OF WOOD RAIL
10) NW COR BRIDGE	S 08° W	90.66'	SET NAIL/TAG TOP OF WOOD RAIL

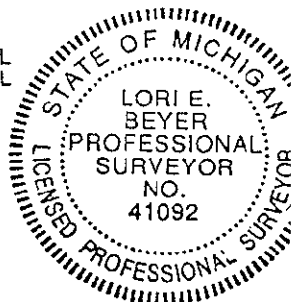

AFTER CAREFUL EXAMINATION OF RECORD DOCUMENTATION AND FIELD OBSERVATIONS, I BELIEVE THIS POINT SHOULD BE ACCEPTED AS THE BEST AVAILABLE EVIDENCE OF THE POSITION OF THE ORIGINAL CORNER.  
THIS CORNER WAS RATIFIED BY THE PEER REVIEW COMMITTEE ON NOVEMBER 22, 1999.

APPROVED  
DATE 11/22/99  
CO. REP. [Signature]

Signed by Lori E. Beyer Date DEC 03, 1999  
Surveyor's Michigan License No. 41092

F-11 CONTINUED FROM PARAGRAPH A



5094704

Page: 2 of 2  
02/07/2000 02:55P

Peggy M. Haines - Washtenaw Co. CORREM L-2 P-283

WASHTENAW COUNTY ROAD COMMISSION GRID BOOK - K. BARKER - 1930  
FOUND LARGE STONE WITH A ROTTED STAKE UNDERNEATH. RESET WITH IRON BAR AND PIECES OF BRICK.

1) 14" ELM	S 15° W	87.75'
2) NE COR. BRDG FL.	S 06° E	91.2'
3) NW COR BRDG FL.	S 05° W	90.5'

L.C.R.C. LIBER 2 PAGE 91 - GLENN RICHARD #13040 - MAY 1972

FOUND 1 1/4" IRON PIPE

4) ELECTRIC POLE	N 40° W	43.70'	SPIKE
5) TELEPHONE POLE	S 65° W	76.30'	SPIKE
6) TELEPHONE POLE	S 40° E	44.66'	BOAT SPIKE
7) TELEPHONE POLE	N 25° E	46.32'	SPIKE

P.A. 132 CERTIFICATE OF SURVEY - LIBER 1440 PAGE 796 - KENNETH SUYDAM #17636 - 1973

FOUND IRON

4) ELECTRIC POLE	N 40° W	43.7'
5) TELEPHONE POLE	S 65° W	76.3'
6) TELEPHONE POLE	S 40° E	44.66'
7) TELEPHONE POLE	N 25° E	46.32'

P.A. 132 CERTIFICATE OF SURVEY - UNRECORDED - ROSKELLY, JEKABSON & ASSOC. - 1980

FOUND 1 1/4" IRON PIPE

4) ELECTRIC POLE	N 40° W	45.05'	NAIL
8) ROAD SIGN	S 40° W	39.85'	
6) MBT POLE	S 40° E	43.96'	NAIL
7) MBT POLE	N 25° E	46.32'	SPIKE

P.A. 132 CERTIFICATE OF SURVEY - UNRECORDED - C. WILSON & ASSOC. - MAY 1986

FOUND 1 1/4" IRON PIPE

4) EDISON POLE	N 40° W	45.04'
6) TELE. POLE	S 40° E	43.97'
7) TELE. POLE	N 25° E	46.32'

WASHTENAW COUNTY ROAD COMMISSION - FIELD BOOK - ROBERT CAMPBELL JR. #13028 - JANUARY 1988

FOUND 1 1/4" IRON PIPE BENT AT TOP 1/2" BELOW GRAVEL

4) ELECTRIC POLE	N 40° W	44.88'
6) TELE. POLE	S 40° E	44.19'
7) TELE. POLE	N 25° E	46.32'

LAND SURVEYING CONSULTANTS - FIELD NOTES - R. TIMOTHY TIETSEMA #20712 - JULY 1989

FOUND 1" IRON PIPE

4) POWER POLE	N 45° W	45.02'	FD NAIL NE SIDE
3) NW COR BRIDGE	S 10° W	90.55'	NE COR OF PLANK
6) POWER POLE	S 45° W	43.99'	FD NAIL NE SIDE (BEARING MAY BE EAST)
7) POWER POLE	N 15° E	46.45'	SET NAIL SE SIDE

SURVEY  
REVISION

MAY 10 2000

SECTION