


Resurvey
 Township 44 N. Range 19 W. Mer. Mich.

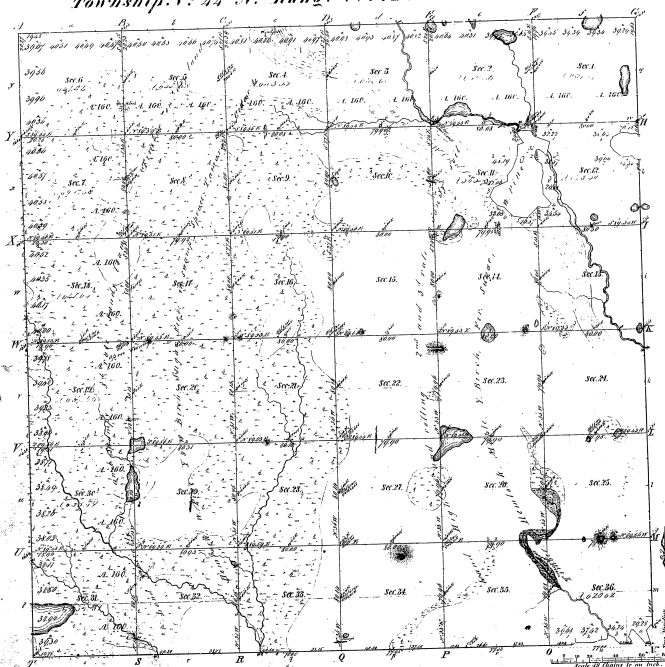

Boundaries of
 Public Courses 1841 Public Courses 1842 Public Courses 1843

37-23

37-23

Total number of Acres 2,122.36

Acres designated	By Whom Surveyed	Date of Survey	Amount of Acres	When Surveyed	By Whom Surveyed
2,122.36	Geo. W. Adams	April 2, 1843	2,122.36	2 nd Quarter 1843	Geo. W. Adams
	A. Montgomery	5, 19, 1843	2,122.36	2 nd Quarter 1843	A. Montgomery

The above map of Township 44 North Range 19 West of the Principal Meridian of Michigan is truly and correctly the full and true survey thereof as filed in the office of the Register and approved by the Register's Office
 Charles Tracy, Reg. 27, 1843

G. W. Adams
 Surveyor

Exam. Copy made
 Nov. 27, 1843

