


Township 1° 44' N. Range 1° 21' W. Mer. Mich.

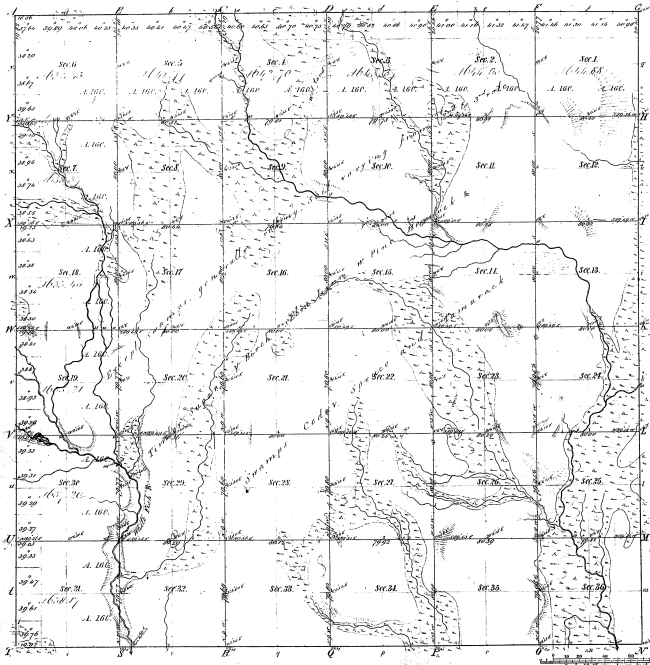

Milestones of			
Post Course 1841	Post Course 1842	Post Course 1843	Post Course 1844
38-2			
38-21			

Total number of Acres 1296

Survey designated	By Whom Surveyed	Date of Certificate	Amount of Survey	When Surveyed	How Surveyed
Township Range	W. B. Steele	April 28 1841	1296	1841	1 Course
Subdivisions	W. B. Steele	April 28 1841	1296	1841	1 Course

The above copy of Township 1° 44' N. Range 1° 21' W. Mer. Mich. is strictly conformable to the field notes of the survey thereon, and has been examined and approved by the Survey General's Office.

Charles Little
Survey General's Office
Detroit June 30 1851

Approved: John B. Steele

Survey General's Office

Detroit June 30 1851

Charles Little

Survey General's Office

Detroit June 30 1851