


Township N° XII. Range N° IV. Mer. (McC. Co.)

13-36

13-36

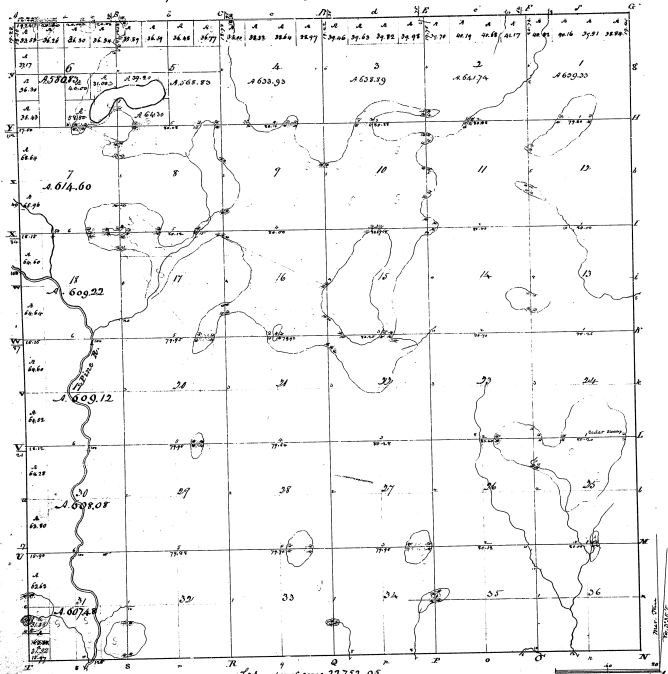

Exhibition of acres 22752.05

Original	Amended	date of	amount of
Survey	Survey	the	the
17, Nov 1814	20, Nov 1836	61, 67, 71	2, 3, 4, 5, 6, 7, 8, 9, 10, 11, 12, 13, 14, 15, 16, 17, 18, 19, 20, 21, 22, 23, 24, 25, 26, 27, 28, 29, 30, 31, 32, 33, 34, 35, 36

This map of Township N° XII, Range N° IV, Mer. (McC. Co.) was prepared by the Surveyor General of the Territory of Montana, and is hereby certified to be a true and correct copy of the original filed in the office of the Surveyor General, and approved.

Surveyor General's Office
 Helena, Mont., Sept. 11, 1852
 M. T. Williams
 Surveyor General