


Re Survey  
Township 1<sup>o</sup> 25' N Range 1<sup>o</sup> 7' W Mer. Mich.

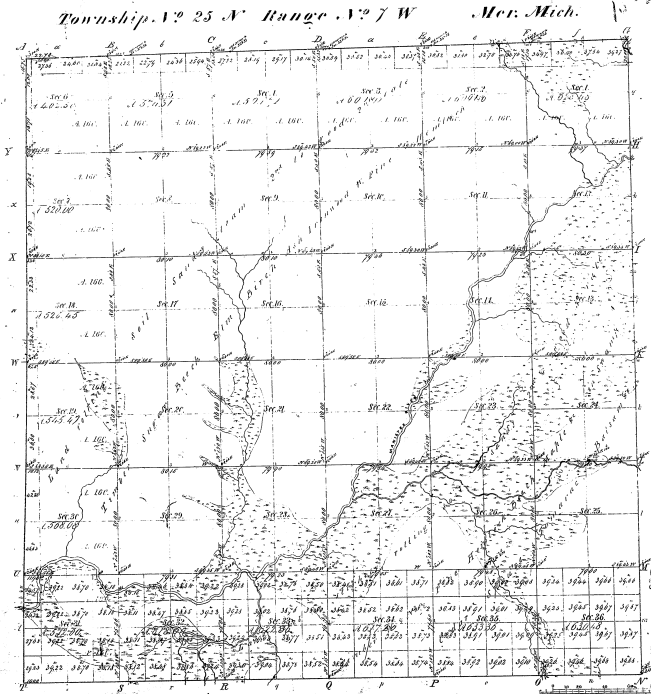

Number of  
Acres Contained in Each Section

Section	Acres	Section	Acres	Section	Acres
1		13		25	
2		14		26	
3		15		27	
4		16		28	
5		17		29	
6		18		30	
7		19		31	
8		20		32	
9		21		33	
10		22		34	
11		23		35	
12		24		36	

15-237

Total number of Acres 22,125.19

Survey designated	By whom surveyed	Date of Contract	Amount of Survey	When Surveyed	When made up and returned to the Surveyor General
Township 1 <sup>o</sup> 25' N	John Stewart	May 21 <sup>st</sup> 1866	16 00 00	1866	1866
Subdivided	John Stewart	March 26 <sup>th</sup> 1868	58 49 81	1868	1868
Subdivided	John Stewart	May 18 <sup>th</sup> 1868	6 00 00	1868	1868

The above Map of Township 1<sup>o</sup> 25' N Range 1<sup>o</sup> 7' W of the Principal Meridian of Michigan is strictly conformable to the field notes of the survey thereof on file in this office and has been examined and approved by the Surveyor General's Office.

Saml. C. Knappe  
Surveyor General