


Township N. 9 N., Range N. 10 E., Mer. (Mich.)

27-7

185
27-7

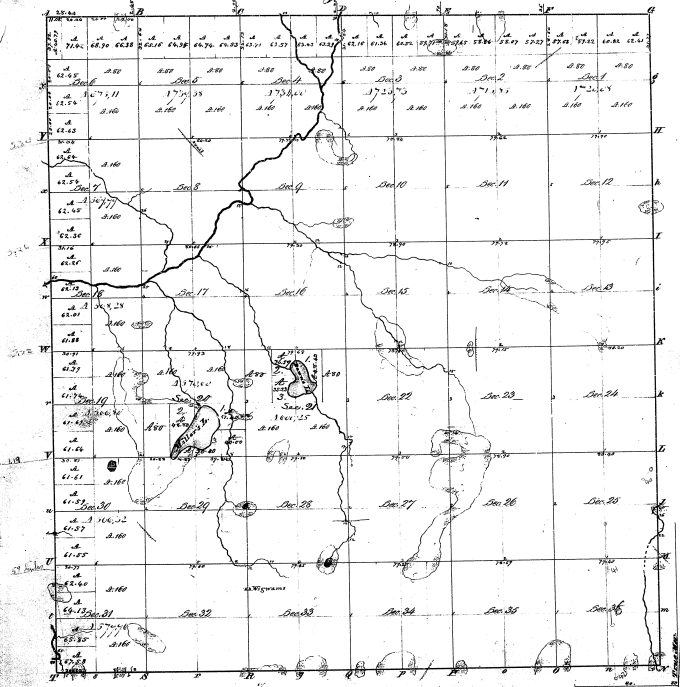

Number of
Mileage
in 0.6184 0.000
10.00 0.00 0.00
Mileage 54.66

Section	Mileage
1	0.00
2	0.00
3	0.00
467.06

Scale 200 ft. to an inch.

Survey Designated	By Whom	Length of Section	Area of Section	Area of Township
1
2
3
The above maps of Township N. 9 N., Range N. 10 E., Mer. (Mich.) are strictly conformable with the field notes of the survey thereof, on file in this office, which have been examined, and approved.
George Cassell, Surveyor
Ann Arbor, Mich. 22. 1855

M. J. Williams
Cor. Sec.