


Township No 19 N. Range No 16 West Mer. (Mich.)

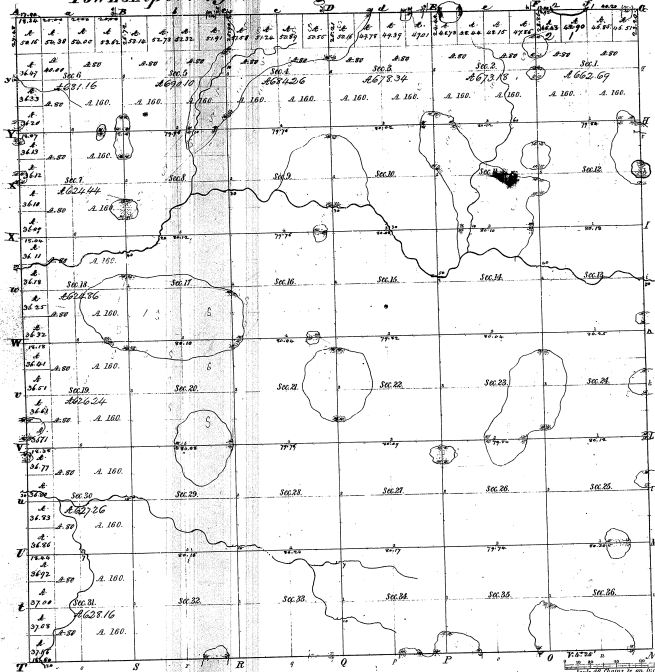

Numbers of parts of a State in Section 1.

Part	Source	Value	Part	Source	Value	Part	Source	Value
1	1860	1.50	2	1860	1.50	3	1860	1.50
4	1860	1.50	5	1860	1.50	6	1860	1.50
7	1860	1.50	8	1860	1.50	9	1860	1.50

10-8
10-8

Total number of Acres 23,262.69

Package designated	By whom prepared	Date of Contract	Amount of Survey	When Surveyed	How far and by whom
Township lines	W. A. 1827	22	27	1827	2 p. 1828
Subdivisions	Sec. 1-16	W. A. 1828	65	52	1 p. 1829

The above map of Township No 19 N. Range No 16 West
 prepared according to Michigan is truly conformable to the field notes
 of the survey thereof on file in this Office, which have been examined and approved.
 Surveyor General's Office.
 Leominster, Jan. 1839

C. P. REARDON Surveyor Genl.