


Township N° V south, Range NIX East of the Mer. (Mich. Ter.)

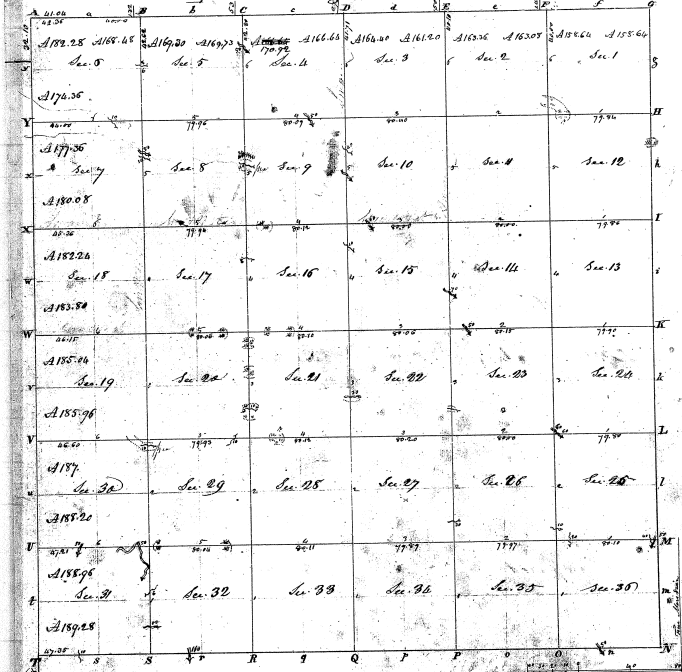

31-22

21-2-2

Reference to a contract with, and numbers from Board of Supervisors, Michigan General of the United States bearing date the 1st day of July 1871.

I have ascertained that said and foregoing the above described township of land and as hereby recited that it has been made and bound both the said and as represented on said list and described on the first note and as mentioned and returned with this list into the Surveyor General's office with file No. 5th day of Oct. 1871 -

J. H. Dutton, P. S.