


Township 1° 31' N Range N° 1 W. Mer. Mich.

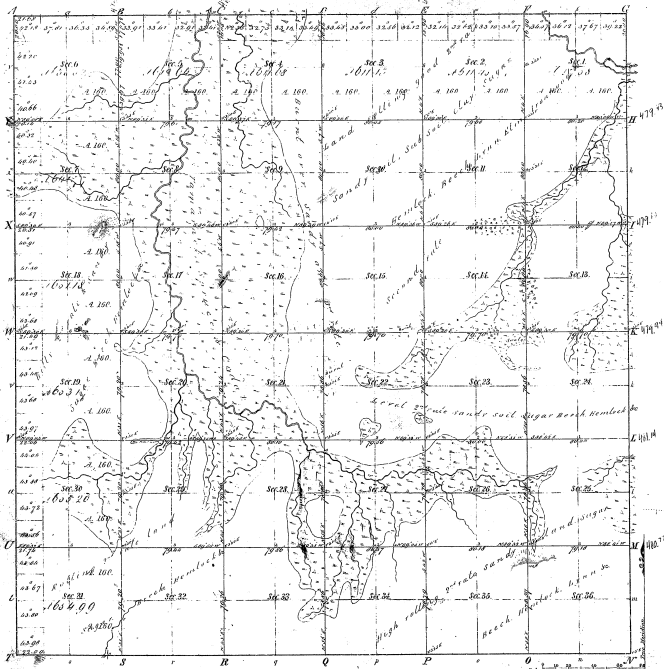

Measures of
 South Course 48° 12' (North) Course 48° 12' (South) Course 48° 12'

19-38
 18-38

Total number of Acres 22,066.20

Survey designated	By whom surveyed	Date of Contract	Amount of Survey	When Surveyed	How far and by what line from the Section
Survey of the	John M. Smith	June 16, 1855	Ac. 22.20	25 June 1855	
Subdivisions	Charles B. Lee	April 22, 1850	Sq. 47. 00	1 st June 1850	

This shows the Township 19 31 North of Range 19 1 West of the Principal Meridian Michigan is a whole conformable to the field notes of the survey thereof on file in this Office, which have been examined and approved.

Surveyor General's Office
 Lansing, Mich. 23. 1855
 Charles H. Wells Sur. Genl.