


Township N^o VII South, Range N^o XVI East of 1st Mer (Black Fox)

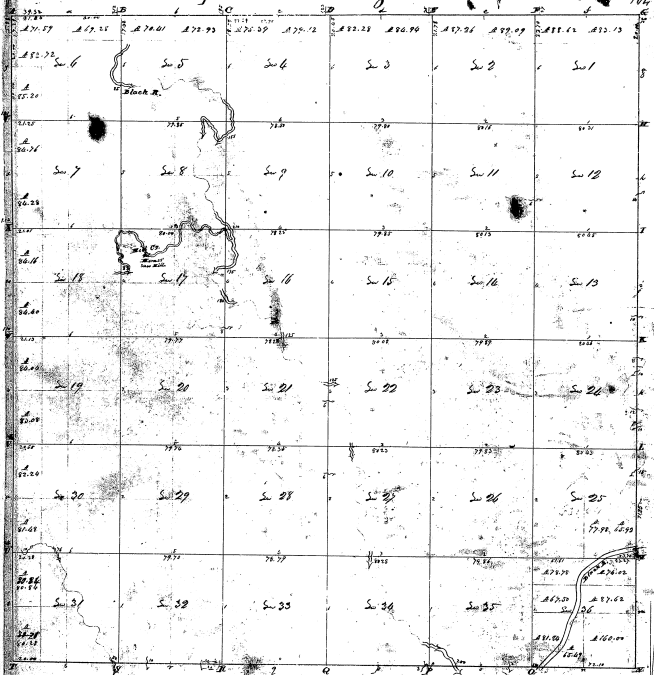

26-11

26-17

Total 33 009 41

Pursuant to a contract with and instructions from Canada by the Dominion of the United States having note to the
 Office mentioned laid out and surveyed the above described township and is hereby that it has such
 roads and bounds by its statutes and act being as are represented on this plat and recorded in the Public Office same being
 in conformity with the laws of the Dominion of the United States - Witness this 1st day of June 1872

Lucius S. ...