Mullett's & Tom 25-8 E Mich.

22-21

Resurvey

Township No. 25 N. Range No. 8 E. (Mich.) Mer.

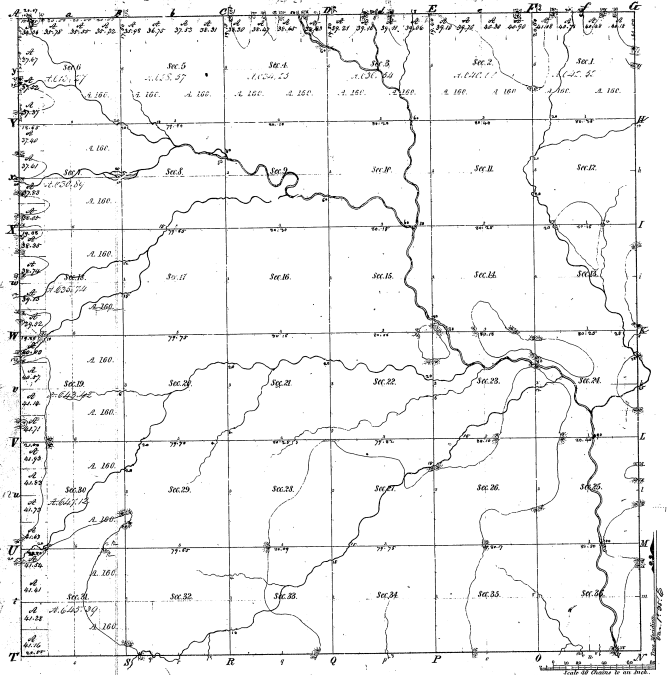

Meanders of								
Posts	Courses	Ch. Lks.	Posts	Courses	Ch. Lks.	Posts	Courses	Ch. Lks.

Total number of Acres 22,997.71

Surveys Designated	By Whom Surveyed	Date of Contract	Amount of Surveys	When Surveyed	When of the Surv. Gen. Ld. Ofc.
Township lines	Lewis Gibson	Aug. 16th 1843	25 Ch. 78 Lk. 67	2d Sep. 1843	4th Sep. 1843
Subdivisions	Mullett & Tom	Aug. 27th 1843	25 Ch. 78 Lk. 74	3d Sep. 1843	11th Sep. 1843

The above Map of Township No. 25 North of Range No. 8 East of the Principal Meridian Michigan is strictly conformable to the field notes of the survey thereof on file in this Office, which have been examined and approved.

Surveyor General's Office,
Cincinnati, December 9th 1843

William Johnston
Sur. Genl.