Resurvey

Township No. 44 N. Range No. 20 W. Mer. Mich.

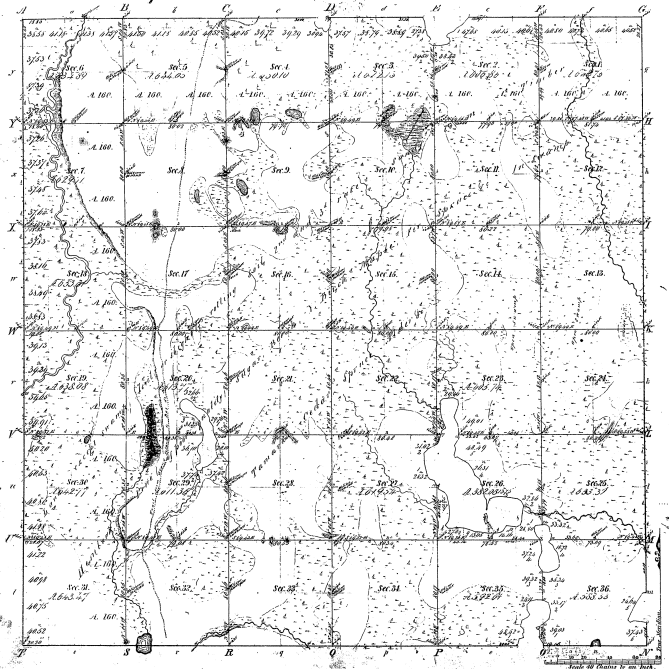

Meanders of							
Poste	Courses	Chs. Lks.	Poste	Courses	Chs. Lks.	Poste	Courses	Chs. Lks.

31.24

Note. Lots shaded yellow were sold prior to the resurvey.

Meanders 10 m. chd. 24 lks.

37.24

Total number of Acres 22494.87

Survey's Designated	By Whom Surveyed	Date of Contract	Amount of Surveys	When Surveyed	
			Ch. Lks. Lks.		
Township lines	H. L. Searls	April 1st 1848	12 00 00	3d Quar. 1848	
Subdivisions	H. B. Searls	April 5th 1848	68 53 91	3d Quar. 1848	

The above Map of Township No. 44 North of Range No. 20 West of the Principal Meridian of Michigan is strictly conformable to the field notes of the survey thereof on file in this Office, which have been examined and approved.

Surveyor General's Office,
Detroit April 18. 1856.

Seaver Chapman
Surv. Genl.