Resurvey

Township No 46 N. Range No 18 W. Mer. Mich.

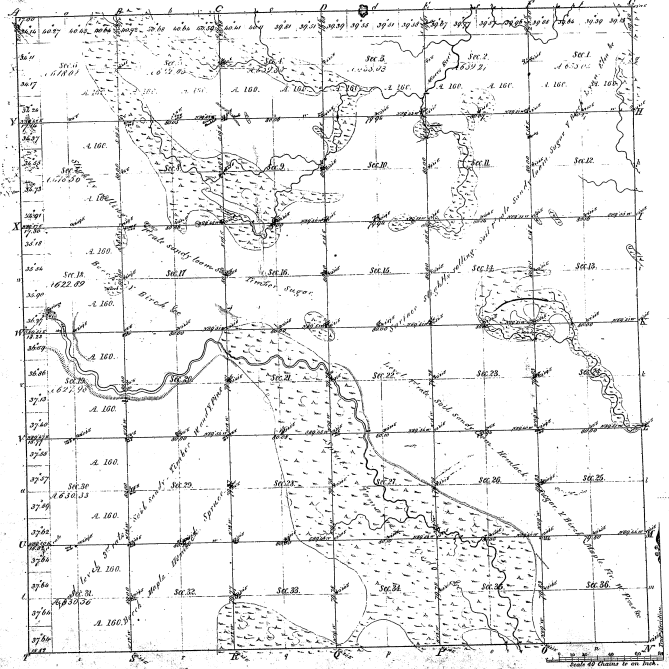

Meanders of

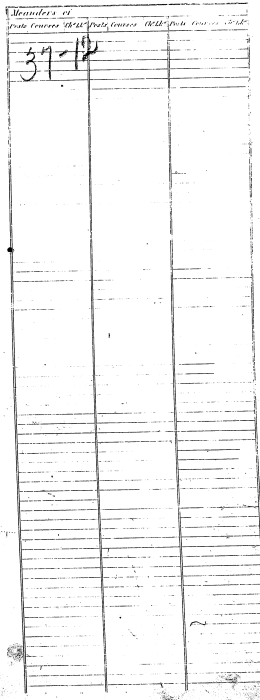

37-17

Total number of Acres 23,040.15

Surveys Designated	By Whom Surveyed	Date of Contract	Amount of Surveys	When Surveyed	When Plat was sent to the Surr. Gen.l's Office
Township lines	William A. Burt	January 8th 1855	M. 157 Chs. 44	2d Quar. 1855	
Resurvey Subdivisions	Geo. E. Adair	April 4th 1855	59. 1/4 x 80	3rd Quar. 1855	

The above Map of Township No 46 North of Range No 18 West of the Principal Meridian Mich Rigan is strictly conformable to the field notes of the surveys thereof on file in this Office, which have been examined and approved.

Surveyor Generals Office
Detroit Dec 8 1855

Surveyor General

Chas. C. Trowbridge
Dep. Clerk