Township No. 46 N Range No. 22 W Mer. Mich.

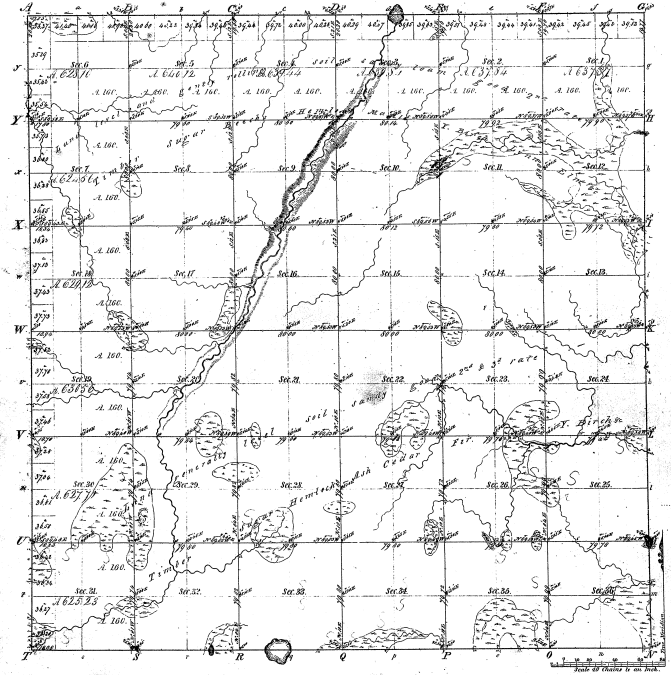

Meanders of								
Posts	Courses	Ch.s Lk.s	Posts	Courses	Ch.s Lk.s	Posts	Courses	Ch.s Lk.s
38	6							

38-6

Total number of Acres. 22,960.39

Surveys Designated	By Whom Surveyed	Date of Contract	Amount of Surveys	When Surveyed	When p.d for and ch.d in the Sur.l Gen.l Ofc.s
Township Office	John Burt	April 1st 1841	36 Ch.s 77 Lks. 85	3d Quar. 1841	
Subdivisions	Alfred Millard	Bond Dec 18 1852	39 80 00	1st & 3d Quar. 1852	

The above Map of Township No. 46 N of Range No. 22 W. of the Principal Meridian of Michigan is strictly conformable to the field notes of the survey thereof on file in this Office which have been examined and approved.

Surveyor General's Office.
Detroit May 26 1854

Leander Chapman
Sur.r Gen.l