



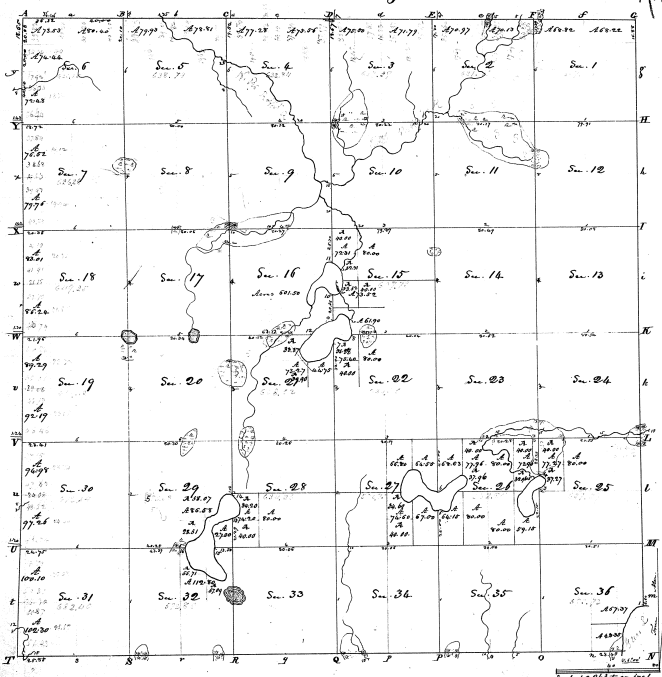


7-31

Surveyed in January 1831 - by *Stephen H. H. H.*

 Surveyor General's Office  
 Cincinnati, Dec. 16th 1831

M. J. Williams  
 for Secy.

Rec. 3009

2009/53