Township N.o IV North, Range N.o XVI West Mer. (Mic. Ter.)

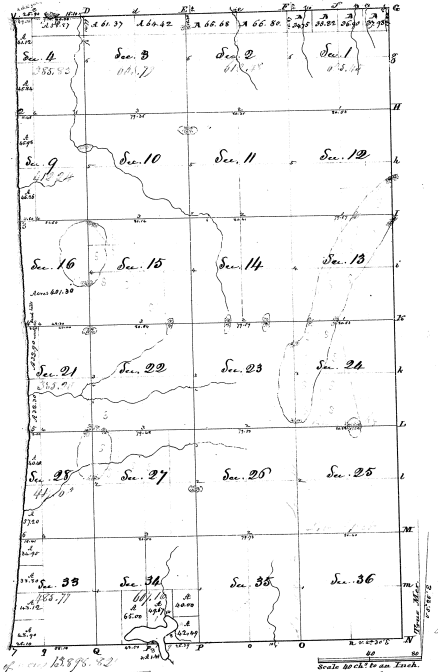

Meanders of Lake Michigan.		
Date	Courses	Ch. Lks.
7.	N 85 E.	34.64
6.	N 6 E.	82.00
5.	N 6 E.	82.50
4.	N W.	80.00
3.	N 3 W.	65.00
2.	N 2 E.	10.00
	N 2 E.	80.00
	Trees	67.50
1.	N W.	8.00
	Meanders of Black River Lake.	
11.	N E.	32.00
10.	N E.	4.00
	Meanders of Lake in Sec. 24.	
9.	N W.	3.60
	Trees	3.50
	N W.	4.00
	West	32
	N W.	2.00
	N W.	11.00
	N W.	5.00
	N E.	3.00
	N E.	6.00
	N E.	5.00
	N E.	1.00
	N E.	6.00
	N E.	7.00
	N E.	4.00
	N W.	3.50
	N W.	0.50
	N E.	5.00
	N E.	14.00
	N W.	10.00
	N E.	5.50
8.	N E.	2.15

Surveys Disputed	By whom dumped	Date of Contract	Amount of Surveys	When Surveyed	When Approved by Surveyor Gen.l of Public Lands
Boundaries	A. Ogden	12. Nov. 1830			
Subdivision	G. Britain	18. " "	43.02.73	Dec. 1831	2.d Sept. 1833

The Above Maps of Township N.o 4 North, of Range N.o 16 west of the Meridian, Michigan Territory is strictly conformable to the field notes of the survey thereof on file in this Office, which have been examined and approved.

Surveyor Generals Office
Cincinnati Sept. 6. 1833

M. T. Williams
Surv. Gen.l