


Res. No. 1  

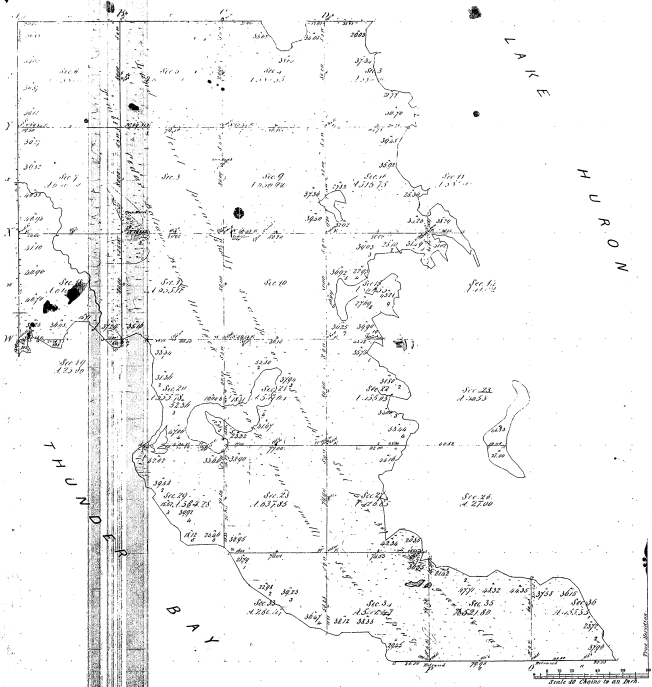



The above Map of Township N.º 31 North of Range N.º 9 East of the Principal Meridian of Michigan is truly conformable to the full and true survey thereof as shown on the original, which have been examined and approved.  

