Thunder Bay Islands

Township N.o 31 N. Range N.o 10 E. Mer. Mich.

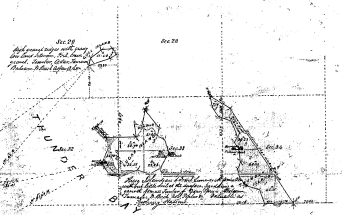

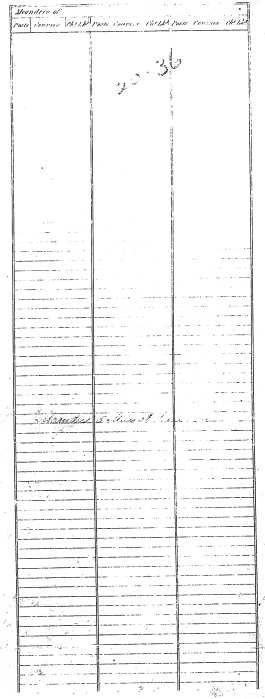

Note. The Islands depict the extent of the Public Surveys but no Instructions letter dated Sep.t 1842

Scale 40 Chains to an Inch.

Total number of Acres

Surveys suspended	By Whom Surveyed	Date of Contract	Amount of Surveys Acres	When Surveyed	When Charged to the Surveyor and Ag.t
Township Lines	Thos. Whipple	Instructions Sep.t 29.th 1842	32 . 32		
Subdivisions	Thos. Whipple	Contract same date	2.nd Class 23040		

The above, Map of Township N.o 31 N. of Range N.o 10 E. of the Principal Meridian in the State of Michigan is conformable to the returns of the survey thereof on file in this Office which have been examined and approved.

Surveyor Generals Office Detroit Nov.r 4.th 1846 Lucius Lyon Surv.r Gen.l

20-36-3