Re Survey.

Township No. 20 N. Range No. 5 E. Mer. Mich.

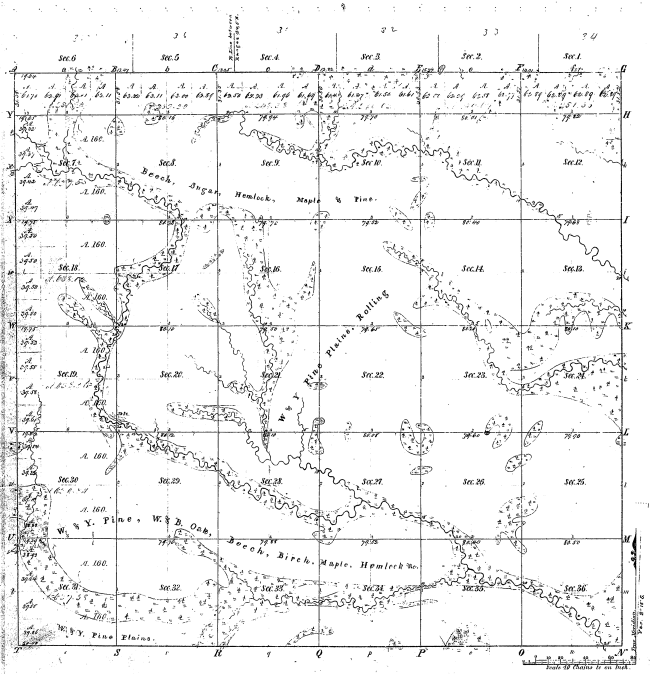

Meanders of											
Posts	Courses	Ch.s Lk.s	Posts	Courses	Ch.s Lk.s	Posts	Courses	Ch.s Lk.s	Posts	Courses	Ch.s Lk.s

32-11

Total number of Acres 20686.81

Surveys Designated	By Whom Surveyed	Date of Contract	Amount of Surveys	When Surveyed	When p.d for and ch.d in the Sur. Gen.l Ser.
Township lines	Lucius Lyon	July 10. 1837	M. Ch.s Lks.	1st q.r 1837	
Subdivisions	B. H. Hall	Jany. 11. 1846	36 74 53	2d q.r 1846	

The above Map of Township No. 20 North of Range No. 5 East of the Principal Meridian Northwest is strictly conformable to the field notes of the survey thereof on file in this Office, which have been examined and approved.

Surveyor General's Office
Detroit June 5th 1846

Lucius Lyon Sur. Gen.l

32-11