Township N.° I North, Range N.° VIII West (Mich. Ter.)

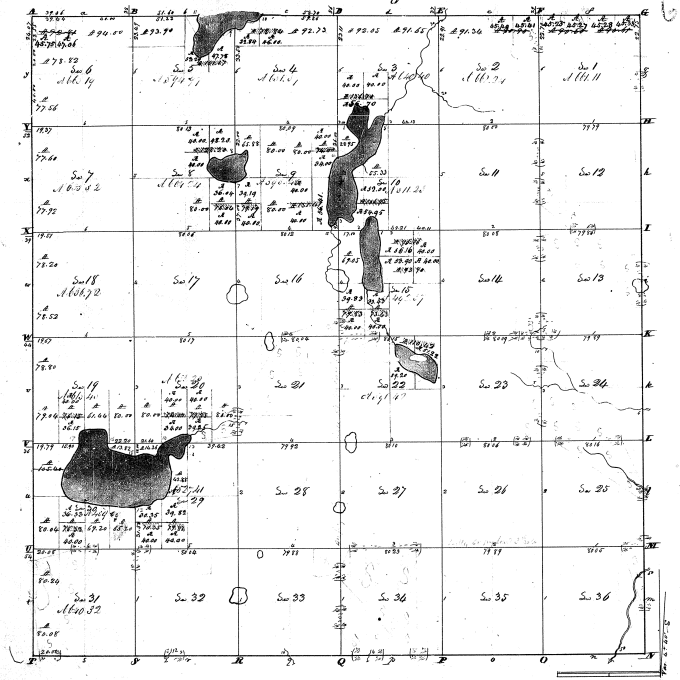

Surveyed in April & May 1826 by Musgrove Evans D.S.

Mx N E 1	90	61	Sw 13	640	
Sx " "	80		14	640	
Mx N W "	90	50	Mx N E 15	96	16
Sx " "	80		Sx " "	93	90
Sx " "	320		N W p. "	69	05
Mx N E 2	90	90	S E "	160	
Sx " "	80		Ex S W "	73	43
Mx N W "	91	34	Mx " "	79	83
Sx " "	80		Sw 16	640	
Sx " "	320		17	640	
Mx N E 3	91	65	Ex 18	320	
Sx " "	80		Ex N W "	80	
Mx N W "	92	05	Mx " "	78	20
Sx " "	80		Ex S W "	80	
S E "	160		Mx " "	78	52
S W "	136	70	N E 19	160	
Mx N E 4	92	73	Ex N W "	80	
Sx " "	80		Mx " "	78	80
Mx N W "	78	84	Ex S E "	80	
Sx " "	80		Mx " "	61	44
Sx " "	320		Ex S W "	76	15
N E 5	101	07	Mx " "	79	04
Mx N W "	93	90	Nx 20	320	
Sx " "	80		Ex S E "	80	
Sx " "	320		Mx " "	79	25
Mx N E 6	94	00	Ex S W "	74	
Sx " "	80		Mx " "	80	
Mx N W "	92	81	Sw 21	640	
Sx " "	78	82	N E 22	110	42
S E "	160		N W "	160	
Ex S W "	80		Sx "	320	
Mx " "	77	56	Sw 23	640	
Ex 7	320		24	640	
Ex N W "	80		25	640	
Mx " "	77	60	26	640	
Ex S W "	80		27	640	
Mx " "	77	92	28	640	
N E 8	128	20	Ex 29	320	
Ex S E "	76	04	Ex N W "	42	88
Mx " "	80		N W p. "	14	36
Mx " "	320		Ex S W "	79	82
Ex N E 9	74		Mx " "	70	35
Mx " "	80		N E p. 30	13	82
Ex N W "	80		N W p. "	105	40
Mx " "	65	88	Ex S E "	65	20
S E "	131	41	Mx " "	69	20
Ex S W "	80		Ex S W "	76	33
Mx " "	79	19	Mx " "	80	04
Ex 10	320		Ex 31	320	
Ex N W "	55	33	Ex N W "	80	
W p. "	28	95	Mx " "	80	24
S W p. "	106	95	Ex S W "	80	
Sw 11	640		Mx " "	80	08
12	640		Sw 32	640	
	7486.95		33	640	
			34	640	
			35	640	
			36	640	
				14865.91	
				7486.95	
				23352.86 Total	

Edward Tiffin Surv. Genl