



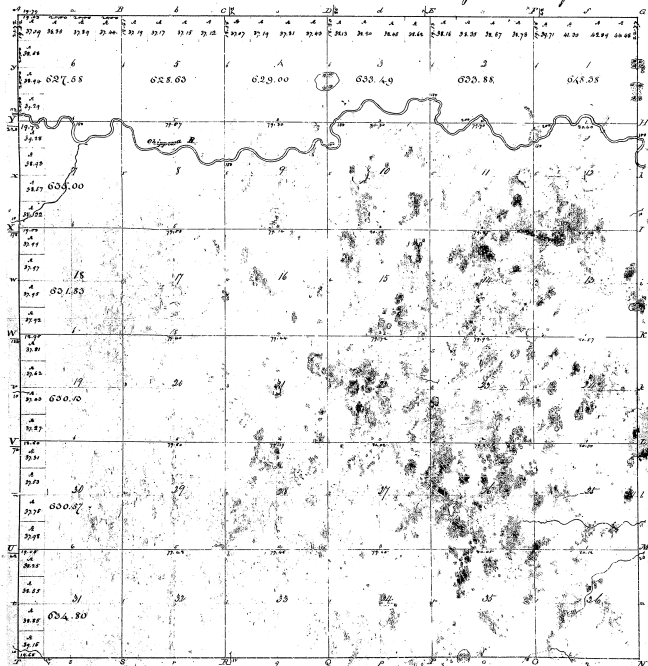




M. T. Williams
 Dec. 1830

13-27
 13-27