Re-survey

Township No. 17 N. Range No. 3 E. Mer. Mich.

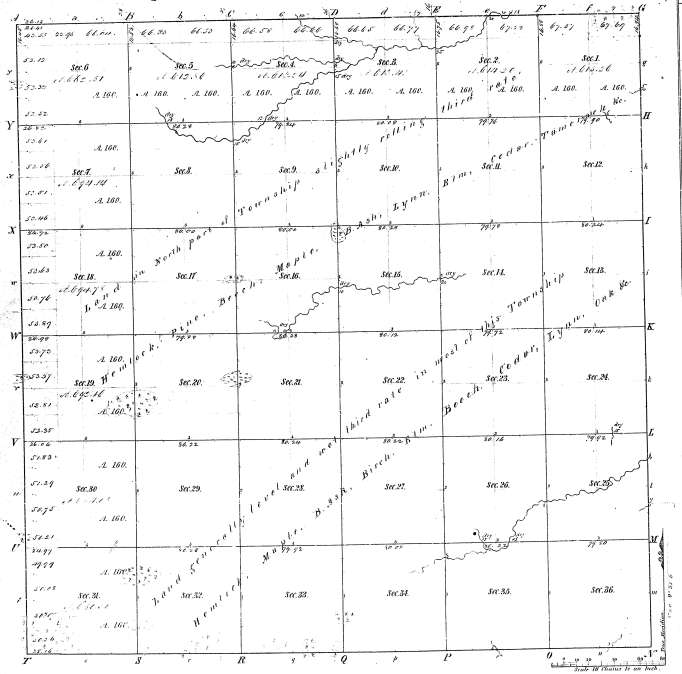

Meanders of								
Posts	Courses	Ch.s Lk.s	Posts	Courses	Ch.s Lk.s	Posts	Courses	Ch.s Lk.s

23-15

Total number of Acres. 23177.15

Surveys Designated	By Whom Surveyed	Date of Contract	Amount of Surveys	When Surveyed	When pd. for and ch.d on the Surv.r Gen.l acc.t
Township lines	Chas. Clark Jr.		M. Chs. Lks.		
Subdivisions	John Mansell	Jany. 11. 1846	60. 15. 03	4th q.r 1831	
				3rd q.r 1846	

The above Map of Township No. 17 North, of Range No. 3 East of the Principal Meridian Michigan, is strictly conformable to the field notes of the survey thereof on file in this Office, which have been examined and approved.

Surveyor General's Office.
Detroit, Nov. 14th 1846.

Lucius Lyon, Sur. Gen.l