Township No. 25 N. Range No. 14 W. Mer. (Mich.)

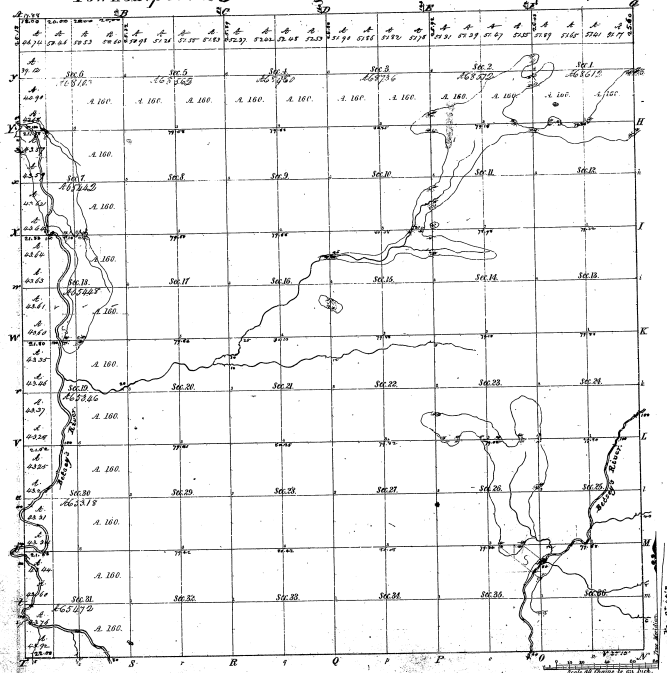

Meanders of

Prate Courses	Ch.	Lks.	Prate Courses	Ch.	Lks.	Prate Courses	Ch.	Lks.

Total number of Acres 23,385.21

Surveys Designated.	By Whom Surveyed.	Date of Contract	Amount of Surveys	When Surveyed	When offered at public sale
Township lines	Alvan Bovee	June 25. 1825	18. 04. 80	1826	1835
Sub-divisions	J. W. A. Burt		60. 37. 82 1/2	1832	
S. Boundary	J. Fonda	Nov. 6. 1834	5. 02. 80	1834	1835

The above Map of Township No. 25 N. of Range No. 14 West of the Principal Meridian Michigan, is strictly conformable to the field notes of the survey thereof on file in this Office, which have been examined and approved.

Surveyor Generals Office
Tecumseh July 25. 1839.

C. S. Fairy Chief Clerk